



SUBMITTAL
DIVISION: 22
NO.: 220500-02

Title: Common Work Results for Plumbing - PG Storm Sewer ST C.L. & O.L. and Water Layout

PRIORITY: High

Division: 22

No.: 220500-02

Contract No.: E6L38

LEAD Project No.: 18-04

DESIGN TEAM REVIEW

Rev.	Description	Received	From	Sent	To	Returned	Forwarded	Status	Days Held
A	Common Work Results for Plumbing - PG Storm Sewer ST C.L. & O.L. and Water Layout	20-Nov-19	KL	21-Nov-19	APCTE			OUT FOR REVIEW	

FDOT REVIEW

Rev.	Description	Received	From	Sent	To	Returned	Forwarded	Status	Days Held



Review is for general conformance with the Contract Documents. Comments shall not be construed as relieving the supplier/subcontractor from strict compliance with such documents. The supplier/subcontractor remain responsible for details and accuracy, for complying with standards of the industry regarding fabrication, assembly, erection, and installation procedures.

REVIEWED
 REVIEWED AS NOTED

REVISED & RESUBMIT
 REJECTED

By: Joanna Flores

Date: 11/21/2019

Walker

Project Submittal Number: _____

- No Exception Taken Make Corrections Noted
Resubmittal not Required
 Rejected Revise and Resubmit
 Submittal Not Required
 No Review Performed

Drawings have been reviewed for design intent and general compliance with the information given in the contract documents. Deviations from contract documents shall be clearly identified and are not reviewed nor accepted unless identified. Contractor is responsible for dimensions, quantities, fabrication, processes, and techniques of construction, coordination of its work with that of all other trades and satisfactory performance of its work.

Date: 12/01/2019 By: JStirling



Submittal #124.0
22 0500G (PGTH) - COMMON
WORK RESULTS FOR
PLUMBING (WALKER)

Kaufman Lynn Construction, Inc.
3185 S. Congress Avenue
Delray Beach, Florida 33445
Phone: 561-361-6700
Fax: 561-361-6979

Project: 1074 - Golden Glades Multimodal Transportation Facility
SW Quadrant of the Golden Glades Interchange Miami-Dade
Florida

**Common Work Results for Plumbing - Parking Garage Storm Sewer
(ST C.L. & O.L.) and Water Layout**

SPEC SECTION:	22 0500G (PGTH) - COMMON WORK RESULTS FOR PLUMBING (WALKER)	SUBMITTAL MANAGER:	Tom Reeder (Kaufman Lynn Construction, Inc.)
STATUS:	Open	DATE CREATED:	11/20/2019
ISSUE DATE:	11/20/2019	REVISION:	0
RESPONSIBLE CONTRACTOR:	Integ Miami LLC	RECEIVED FROM:	Daniela Salas
RECEIVED DATE:	11/15/2019	SUBMIT BY:	11/15/2019
FINAL DUE DATE:	11/28/2019	LOCATION:	
SUB JOB:		COST CODE:	
LEAD TIME:		TYPE:	Shop Drawing
APPROVERS:	Mario Rojas (A & P Consulting Transportation Engineers Corp.)		
BALL IN COURT:	Joanna Flores (Lead Engineering Contractors)		
DISTRIBUTION:	Carlos Teijeiro (Kaufman Lynn Construction, Inc.) , Tom Reeder (Kaufman Lynn Construction, Inc.) , Leonor Flores (Kaufman Lynn Construction, Inc.) , Joanna Flores (Lead Engineering Contractors)		
DESCRIPTION:			
ATTACHMENTS:	#22 0500G-2 Common Work Results for Plumbing - PG Storm Sewer & Water Shop Drawing Layout - Submitted.pdf		

SUBMITTAL WORKFLOW

NAME	SUBMITTER/ APPROVER	SENT DATE	DU DATE	RETURNED DATE	RESPONSE	ATTACHMENTS	COMMENTS
Joanna Flores	Submitter		11/21/2019		Pending		
Mario Rojas	Approver		11/28/2019		Pending		

BY

DATE

COPIES TO



FO-INTEG-PROJECT-PO0001-REV.03 Gestión de Control de Calidad / Quality Management

Information

Status: In Review

Task/tareas condition

Legend

Overdue Issue On Time Delayed Start Inactive

Project (CDC) - Empresa/
COMPANY: Integ Miami LLC

Project (CDC) - CDC (Centro
de Costo) I-PLUMBING-GGMTF-021919

Project (CDC) - Customer
Name Kaufman Lynn Construction

Project (CDC) - Ubicacion 15890 Northwest 7th Avenue, Miami, Florida 33169

Submittal

Title: Shop Drawings Plumbing Parking Garage REV 4

Spec Section: SECTION 22 0529
SECTION 22 0553
SECTION 22 0716
SECTION 22 1005
SECTION 22 1116G
SECTION 22 1413G

Description: Shop Drawings Plumbing - Parking Garage:
- COVERED LEVEL STORM SEWER LINE (ST C.L.)
- OPEN LEVEL STORM SEWER LINE (ST O.L.)
- WATER LINE (W)

Submittal Type : Shop Drawing

Submitted On: 30-09-2019

Responsible Contractor: Integ Miami LLC

Submittal Manager: Claudio Werneck

Issue Date: 15-11-2019 12:00 AM

Final Due Date: 29-11-2019

Lead Time: 15

Ball in Court: Kaufman Lynn

Attachment

Attachment: SHOP DRAWINGS W-STAMPS.pdf

Linked Drawings:

Notes:
Submitted Shop Drawing REV 1 09/30/2019
Replace Submittal Shop Drawing REV 4 11/15/2019

KAUFMAN LYNN CONSTRUCTION - SUBMITTAL

Project No. 1074 Submittal No. #22 0500G-2

Reviewed _____ Make Corrections Noted

Submit Specified Item

Checking is only for general conformance with the design concept of the project and general compliance with the information given in the Contract Documents. Any action shown is subject to the requirements of the plans and specifications. Subcontractor is responsible for dimensions which shall be confirmed and correlated at the job site, fabrication processes and techniques sequences of construction, coordination of his/her work with that of all trades, and the satisfactory performance of his/her work.

DATE: 11/20/2019 BY: T. REEDER

Show Stamp on PDF:



Submittal logs

Add Submittal LOG

Revision #	Date Submittal REV	Attachment Document:	Comments:
------------	--------------------	----------------------	-----------

No submittal logs found

Submittal Approval

Approval

Name/Title:

Signature _____

Created on Sept. 30 at 12:53 PM (PDT). Last updated by pma@integca.com, PMA today at 7:31 AM (PST). Owned by pma@integca.com, PMA.

KAUFMAN LYNN CONSTRUCTION - SUBMITTAL



Project No. 1074 Submittal No. #22 0500G-2

Reviewed _____ Make Corrections Noted _____

Submit Specified Item

Checking is only for general conformance with the design concept of the project and general compliance with the information given in the Contract Documents. Any action shown is subject to the requirements of the plans and specifications. Subcontractor is responsible for dimensions which shall be confirmed and correlated at the job site, fabrication processes and techniques sequences of construction, coordination of his/her work with that of all trades, and the satisfactory performance of his/her work.

DATE: 11/20/2019 BY: T. REEDER

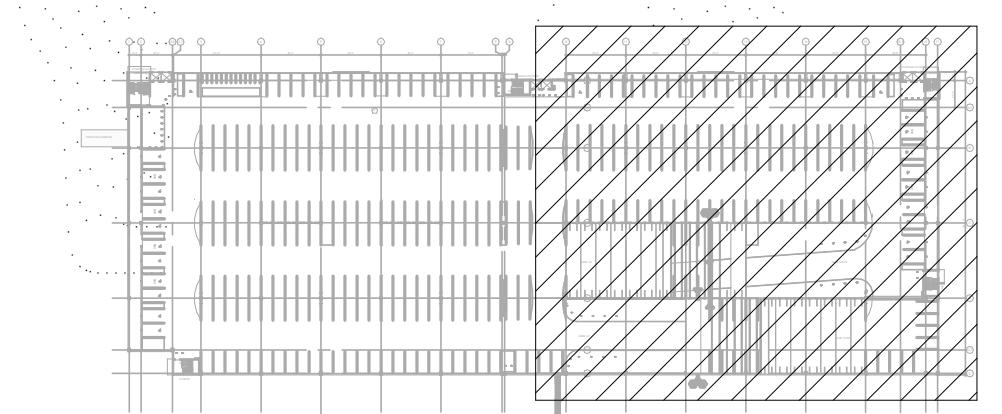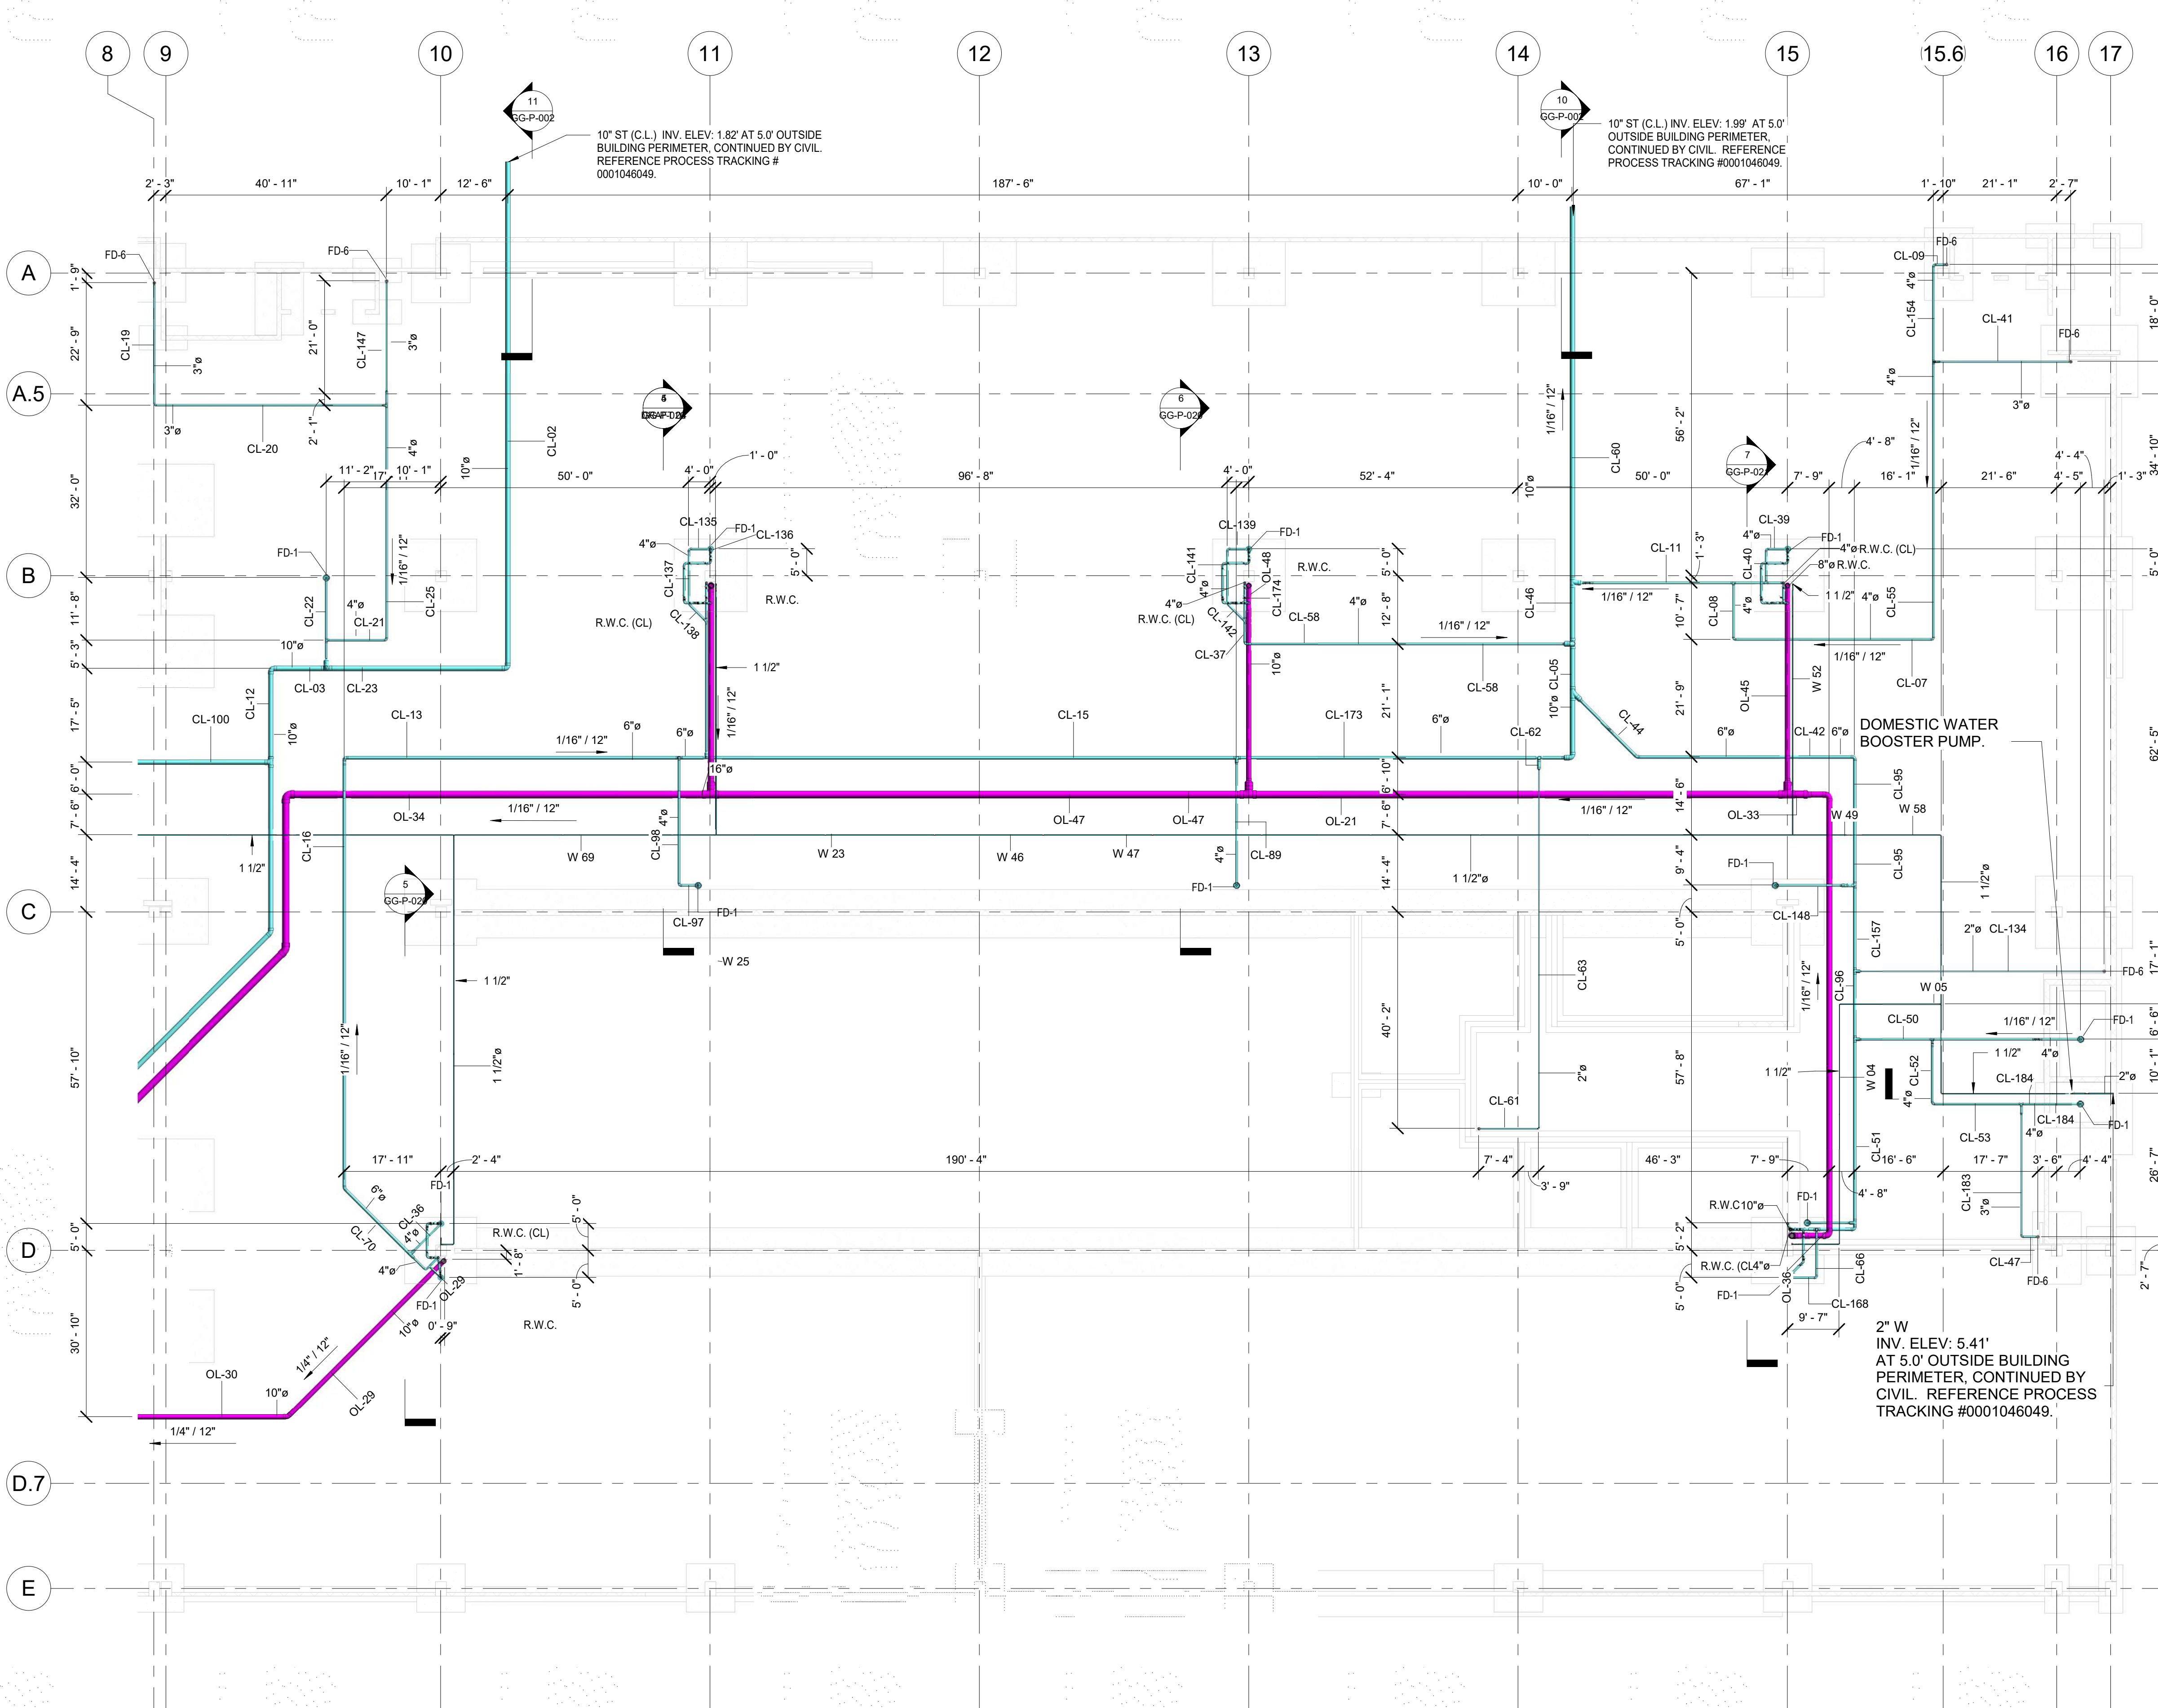


SHOP-DRAWING

InTeg
Integral Engineering

KEY PLAN - EAST SIDE

1" = 160'-0"

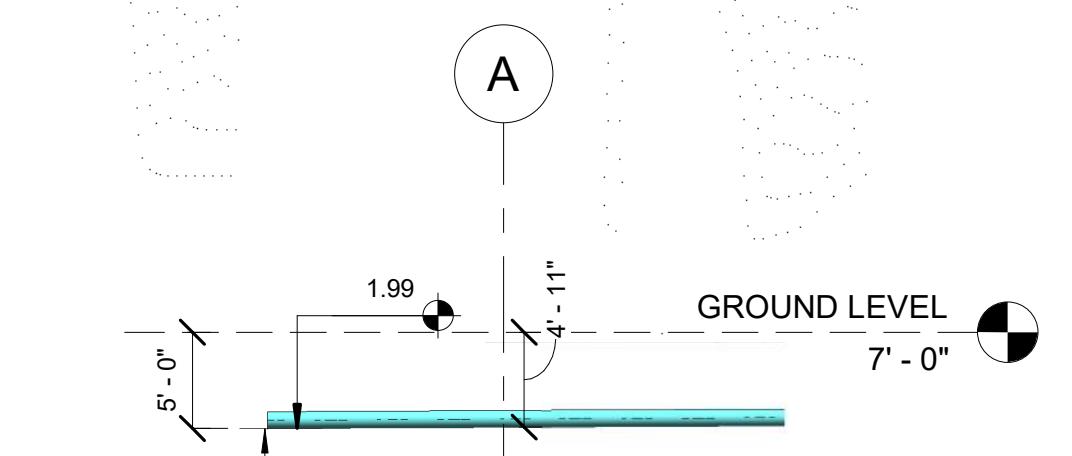

NOMENCLATURE:

W= COOL WATER
CL= SANITARY DRAIN PIPE
CO= STORM DRAIN PIPE


ST (CO) STORM DRAIN PIPE
ST (CL) SANITARY DRAIN PIPE
W WATER PIPE

REFERENCE DRAWING:

PG-P-001/002 - 101A/101B
102A/102B - 103A/103B -
104A/104B - 105A/105B -
106A/107B - 601/602.


SECTION 10

1" = 10'-0"

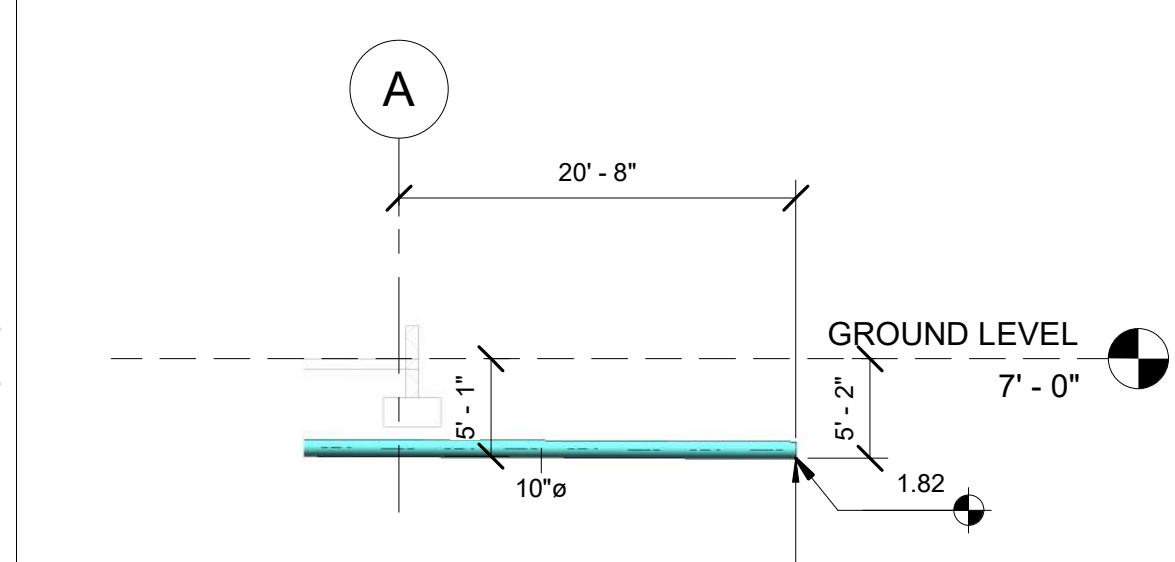

SECTION 11

1" = 10'-0"

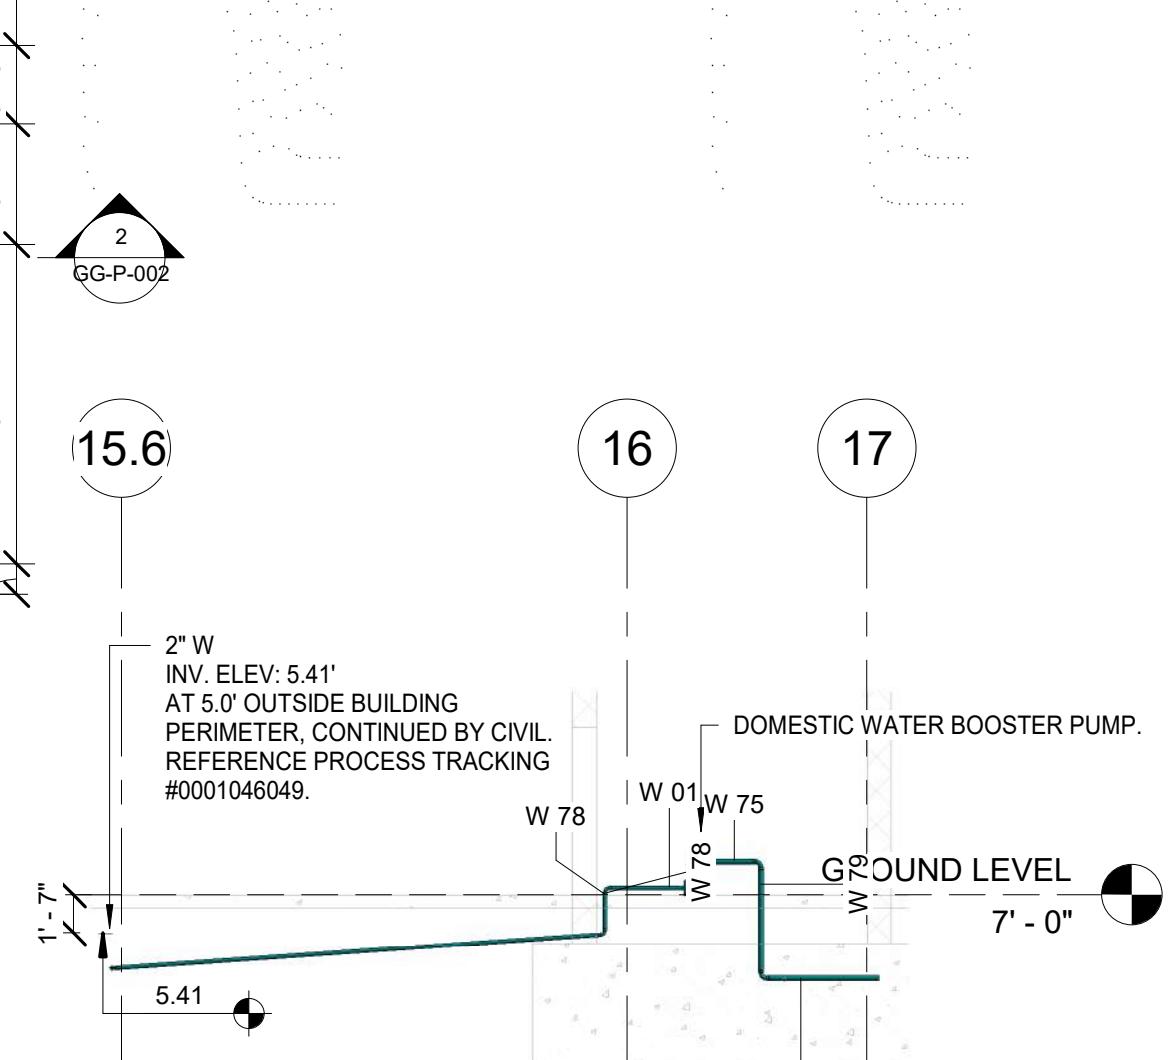

SECTION 12

1/8" = 1'-0"

REV.	DATE	ISSUE FOR REVIEW	INTEG
4	11.08.2019	ISSUE FOR REVIEW	INTEG
3	10.28.2019	ISSUE FOR REVIEW	INTEG
2	09.24.2019	ISSUE FOR REVIEW	INTEG
1	06.10.2019	ISSUE FOR REVIEW	INTEG
0	05.11.2019	FREE FOR USE	INTEG

DEVELOPMENT	REVIEW
INTEG	INTEG

PROJECT:	GOLDEN GLADES - PARKING GARAGE
PROPERTY OF:	

LOCATED:	STATE OF FLORIDA / DEPARTMENT OF TRANSPORTATION MIAMI-DADE ROAD NO. SR 7 / FINANCIAL PROJECT ID 251684-6-52-01
CONTENT:	

Kaufman Lynn Construction - Submittal	Project No. 1074	Submit No. #22 0500G-2
Reviewed	Make Corrections Noted	

Submittal Specified Item	
Checking is only for general conformance with the design concept of the project and general compliance with the information given in the Contract Documents. Any action taken is subject to the requirements of the Contract Documents and specifications. Submittal is responsible for all work which shall be performed and correlated at the job site, fabrication processes and techniques sequences of construction, coordination of his/her work with that of all trades, and the satisfactory performance of his/her work.	

KAUFMAN LYNN CONSTRUCTION - SUBMITTAL
Project No. 1074 Submit No. #22 0500G-2

Reviewed Make Corrections Noted

Submittal Specified Item

Checking is only for general conformance with the design concept of the project and general compliance with the information given in the Contract Documents. Any action taken is subject to the requirements of the Contract Documents and specifications.

Submittal is responsible for all work which shall be performed and correlated at the job site, fabrication processes and techniques sequences of construction, coordination of his/her work with that of all trades, and the satisfactory performance of his/her work.

DATE: 11/20/2019 BY: T. REEDER

DATE: 08/16/19 SCALE: As indicated REVIEW: 4 PROJECT:

CODE: GG-P-002

8
9

10

11

12

13

14

15

16

17

A

A.5

B

C



D

D.7

E

PARTIAL PLUMBING SECOND LEVEL - EAST SIDE

1 1/16" = 1'-0"

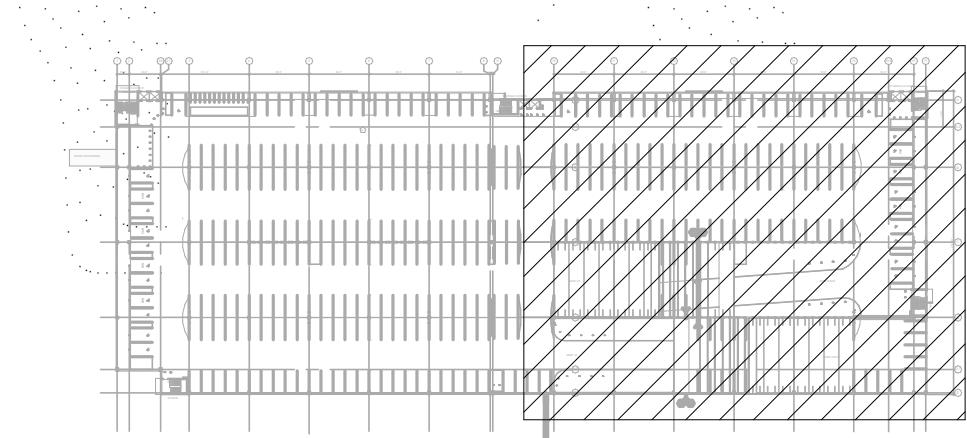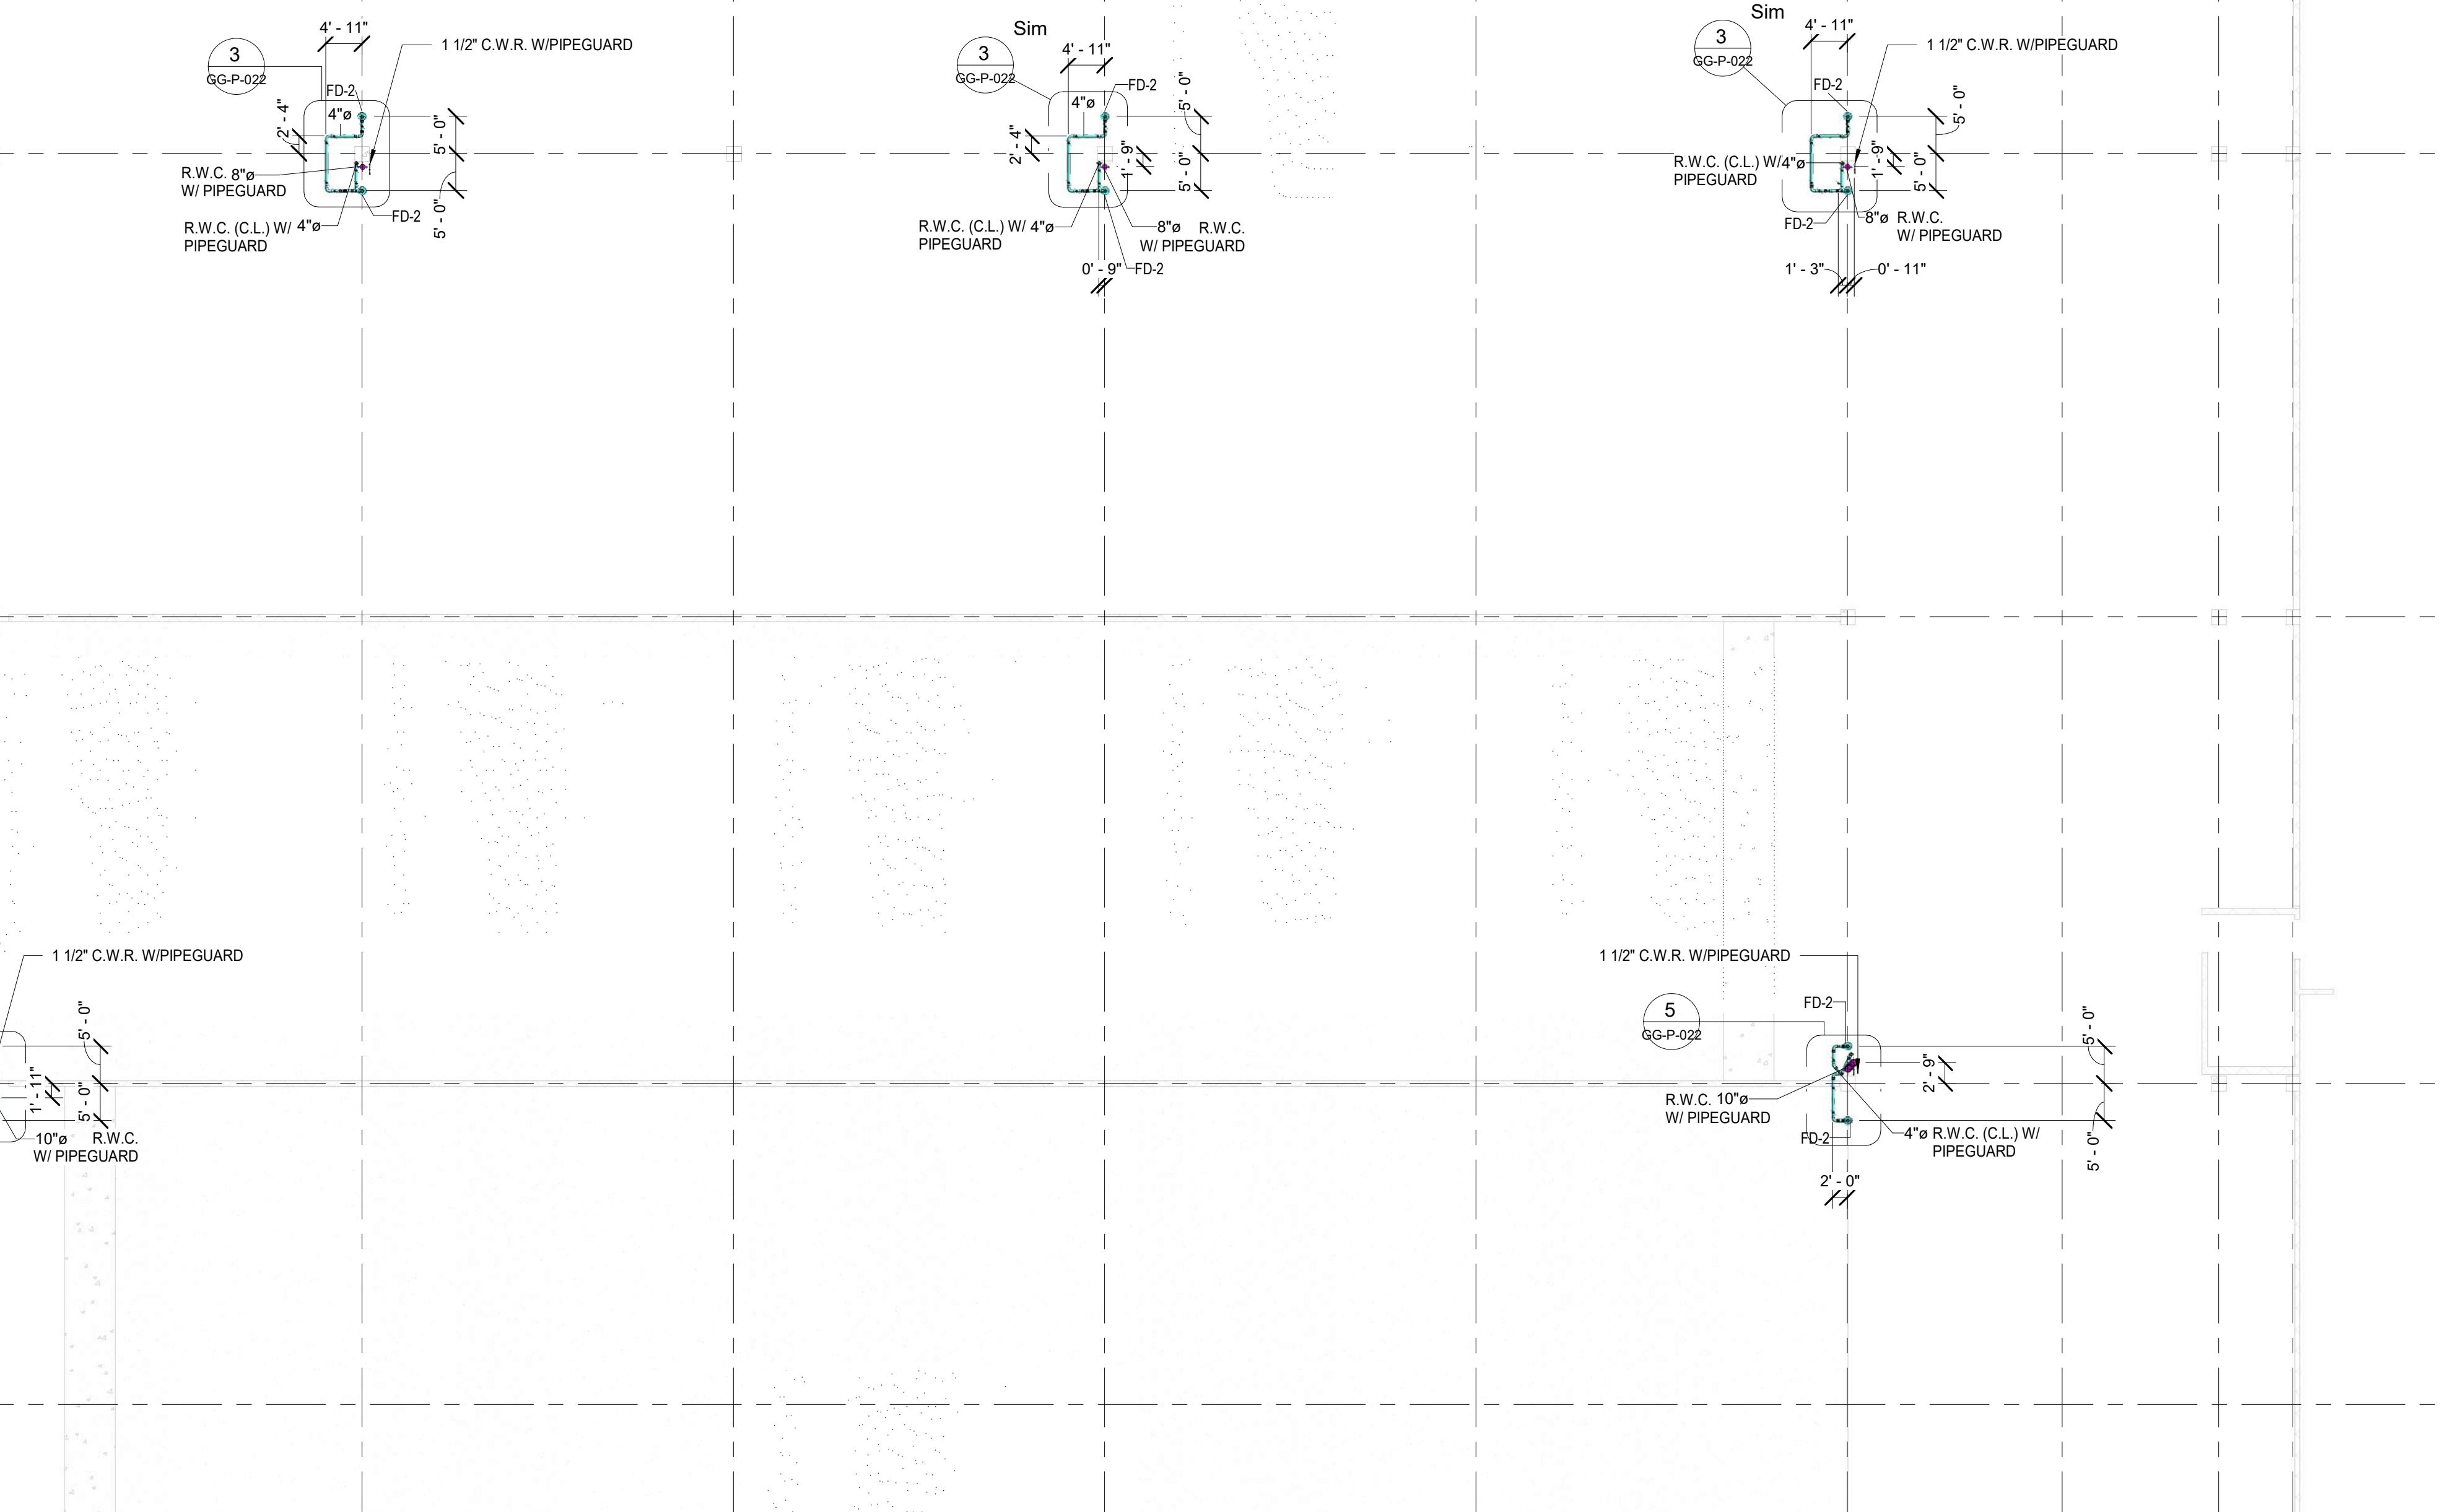**KEY PLAN - EAST SIDE**

1" = 160'-0"

SHOP-DRAWING**NOMENCLATURE:**

W= COOL WATER
CL= SANITARY DRAIN PIPE
CO= STORM DRAIN PIPE

ST (CO) STORM DRAIN PIPE
ST (CL) SANITARY DRAIN PIPE
W WATER PIPE

REFERENCE DRAWING:

PG-P-001/002 - 101A/101B
102A/102B - 103A/103B -
104A/104B - 105A/105B -
106A/107B - 601/602.

REV.	DATE	ISSUE FOR REVIEW	INTEG
4	11.08.2019	ISSUE FOR REVIEW	INTEG
3	10.28.2019	ISSUE FOR REVIEW	INTEG
2	09.24.2019	ISSUE FOR REVIEW	INTEG
1	06.14.2019	ISSUE FOR REVIEW	INTEG
0	05.10.2019	FREQUENTLY ASKED QUESTIONS	INTEG
		DESCRIPTION	APPROVED

DEVELOPMENT	REVIEW
INTEG	INTEG

KAUFMAN LYNN CONSTRUCTION - SUBMITTAL

Project No. 1074 Submittal No. #22 0500G-2

Reviewed Make Corrections Noted

Submit Specified Item

Checking is only for general conformance with the design concept of the project and general compliance with the information given in the Contract Documents. Any action shown is subject to the requirements of the plans and specifications. Subcontractor is responsible for dimensions which shall be confirmed and corrected at the job site, fabrication processes and techniques sequences of construction, and shall work with that of all trades, and the satisfactory performance of his/her work.

DATE: 11/20/2019 BY: T. REEDER



Reviewed for general conformance to the contract documents. This review does relieve the vendor of the responsibility of making the work conform to the plans and the **FDOT Design Standards**.

Submittal #: 39
CDC: I-PLUMBING-GGMTF-021919
Job #: 424
Reviewed by: EDUARDO PEREIRA
Date: 11/08/2019
Vendor: REVISIION
Product: SHOP DRAWINGS.
Description:


LOCATED:

STATE OF FLORIDA / DEPARTMENT OF TRANSPORTATION
MIAMI-DADE
ROAD NO. SR 7 / FINANCIAL PROJECT ID 251684-6-52-01


CONTENT:

PARTIAL PLUMBING PLAN - SECOND LEVEL - EAST SIDE

DATE:	SCALE:	REVIEW:	PROJECT:
08/16/19	As indicated	4	GG-P-004

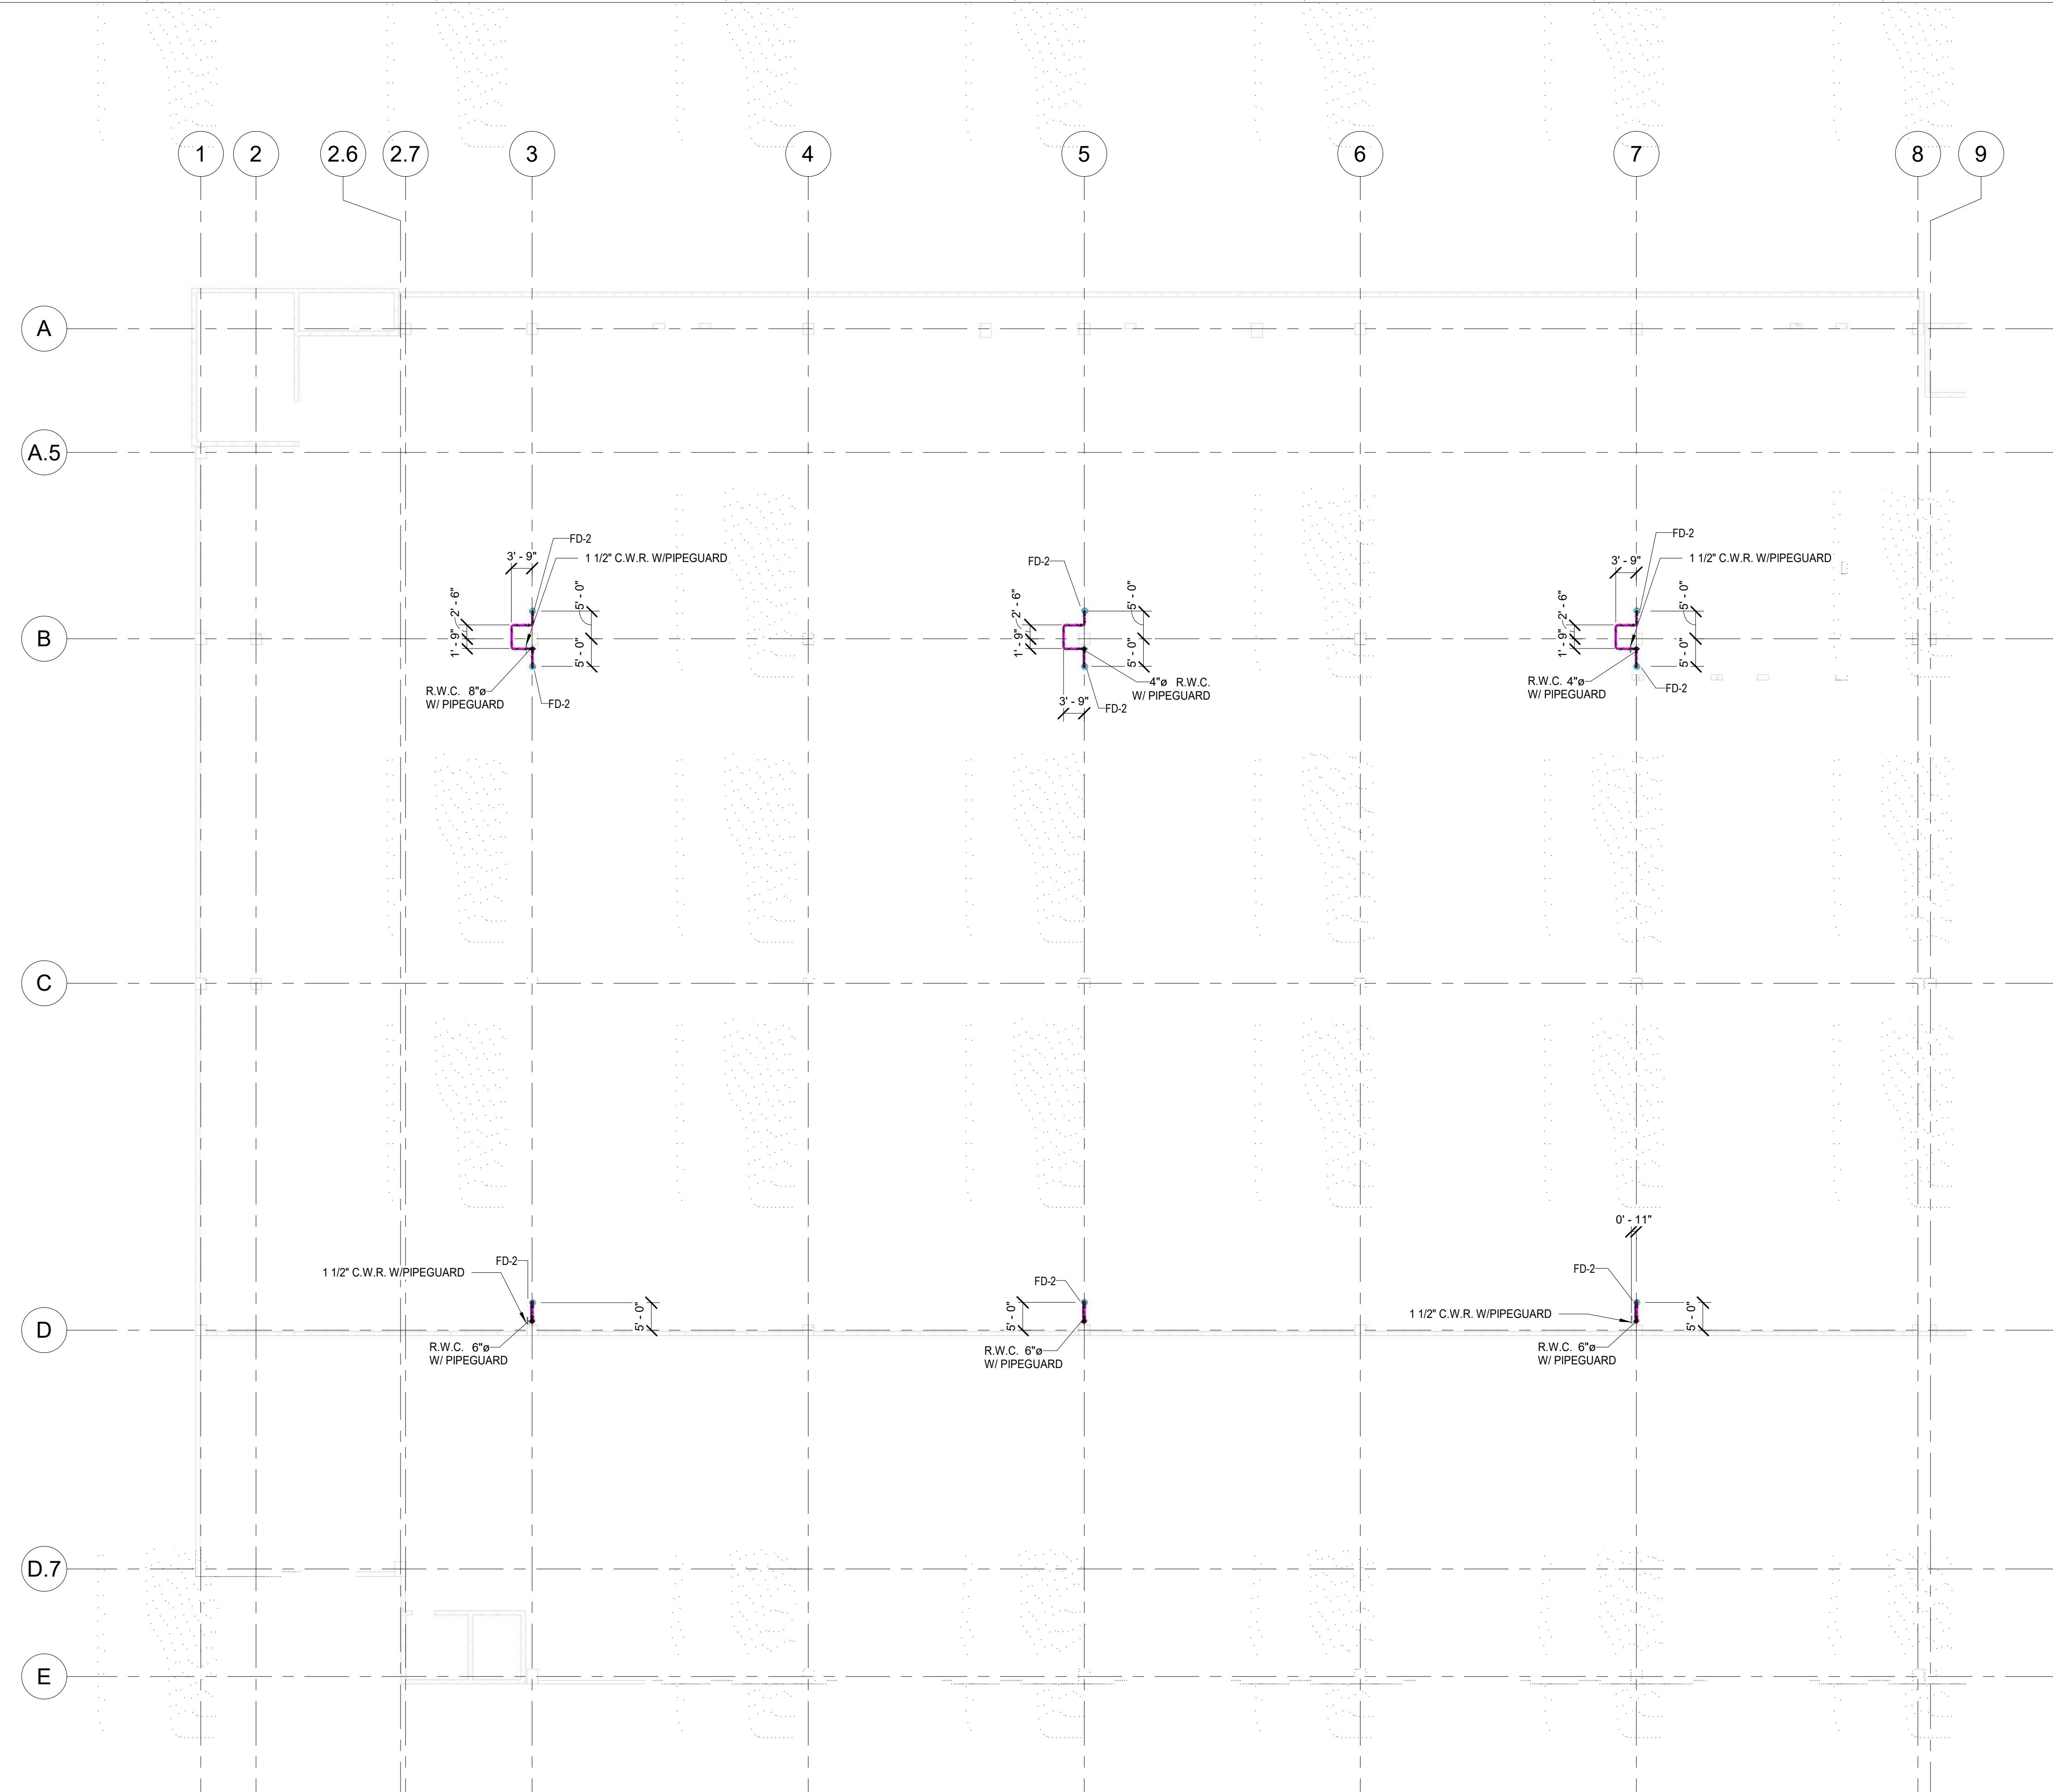

1 PARTIAL PLUMBING FIFTH LEVEL - WEST SIDE
1/16" = 1'-0"

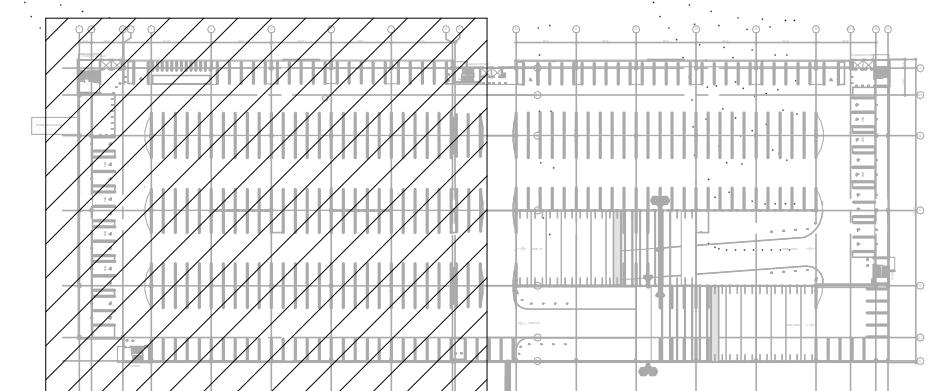

KEY PLAN - WEST SIDE

1" = 160'-0"

SHOP-DRAWING



NOMENCLATURE:

W= COOL WATER
CL= SANITARY DRAIN PIPE
CO= STORM DRAIN PIPE

ST (CO) STORM DRAIN PIPE
ST (CL) SANITARY DRAIN PIPE
W WATER PIPE

REFERENCE DRAWING:

PG-P-001/002 - 101A/101B
102A/102B - 103A/103B
104A/104B - 105A/105B
106A/107B - 601/602.

REV.	DATE	ISSUE FOR REVIEW	INTEG
4	11.08.2019	ISSUE FOR REVIEW	INTEG
3	10.28.2019	ISSUE FOR REVIEW	INTEG
2	09.24.2019	ISSUE FOR REVIEW	INTEG
1	06.10.2019	ISSUE FOR REVIEW	INTEG
0	08.10.2019	FREE FOR REVIEW	INTEG
		DESCRIPTION	APPROVED

DEVELOPMENT	REVIEW
INTEG	INTEG

KAUFMAN LYNN CONSTRUCTION - SUBMITTAL

Project No. 1074 Submittal No. #22 0500G-2

Reviewed Make Corrections Noted

Submitted Specified Item

Checking is only for general conformance with the design concept of the project and general compliance with the information given in the Contract Documents. Any action shown is subject to the requirements of the plans and specifications. Subcontractor is responsible for dimensions which shall be confirmed and checked by the architect, fabricator, engineer and techniques sequence of construction, coordination of his/her work with that of all trades, and the satisfactory performance of his/her work.


DATE: 11/20/2019 BY: T. REEDER




Reviewed for general conformance to the contract documents. This review does not relieve the vendor of the responsibility of making the work conform to the plans and the FDOT Design Standards.

Submittal #: 39
CDC: I-PLUMBING-GGMFT-021919
Job #: 424
Reviewed by: EDUARDO PEREIRA
Date: 11/08/2019
Vendor: REVISION
Product: SHOP DRAWINGS.
Description:

DATE:	SCALE:	REVIEW:	PROJECT:
08/16/19	As indicated	4	GG-P-009

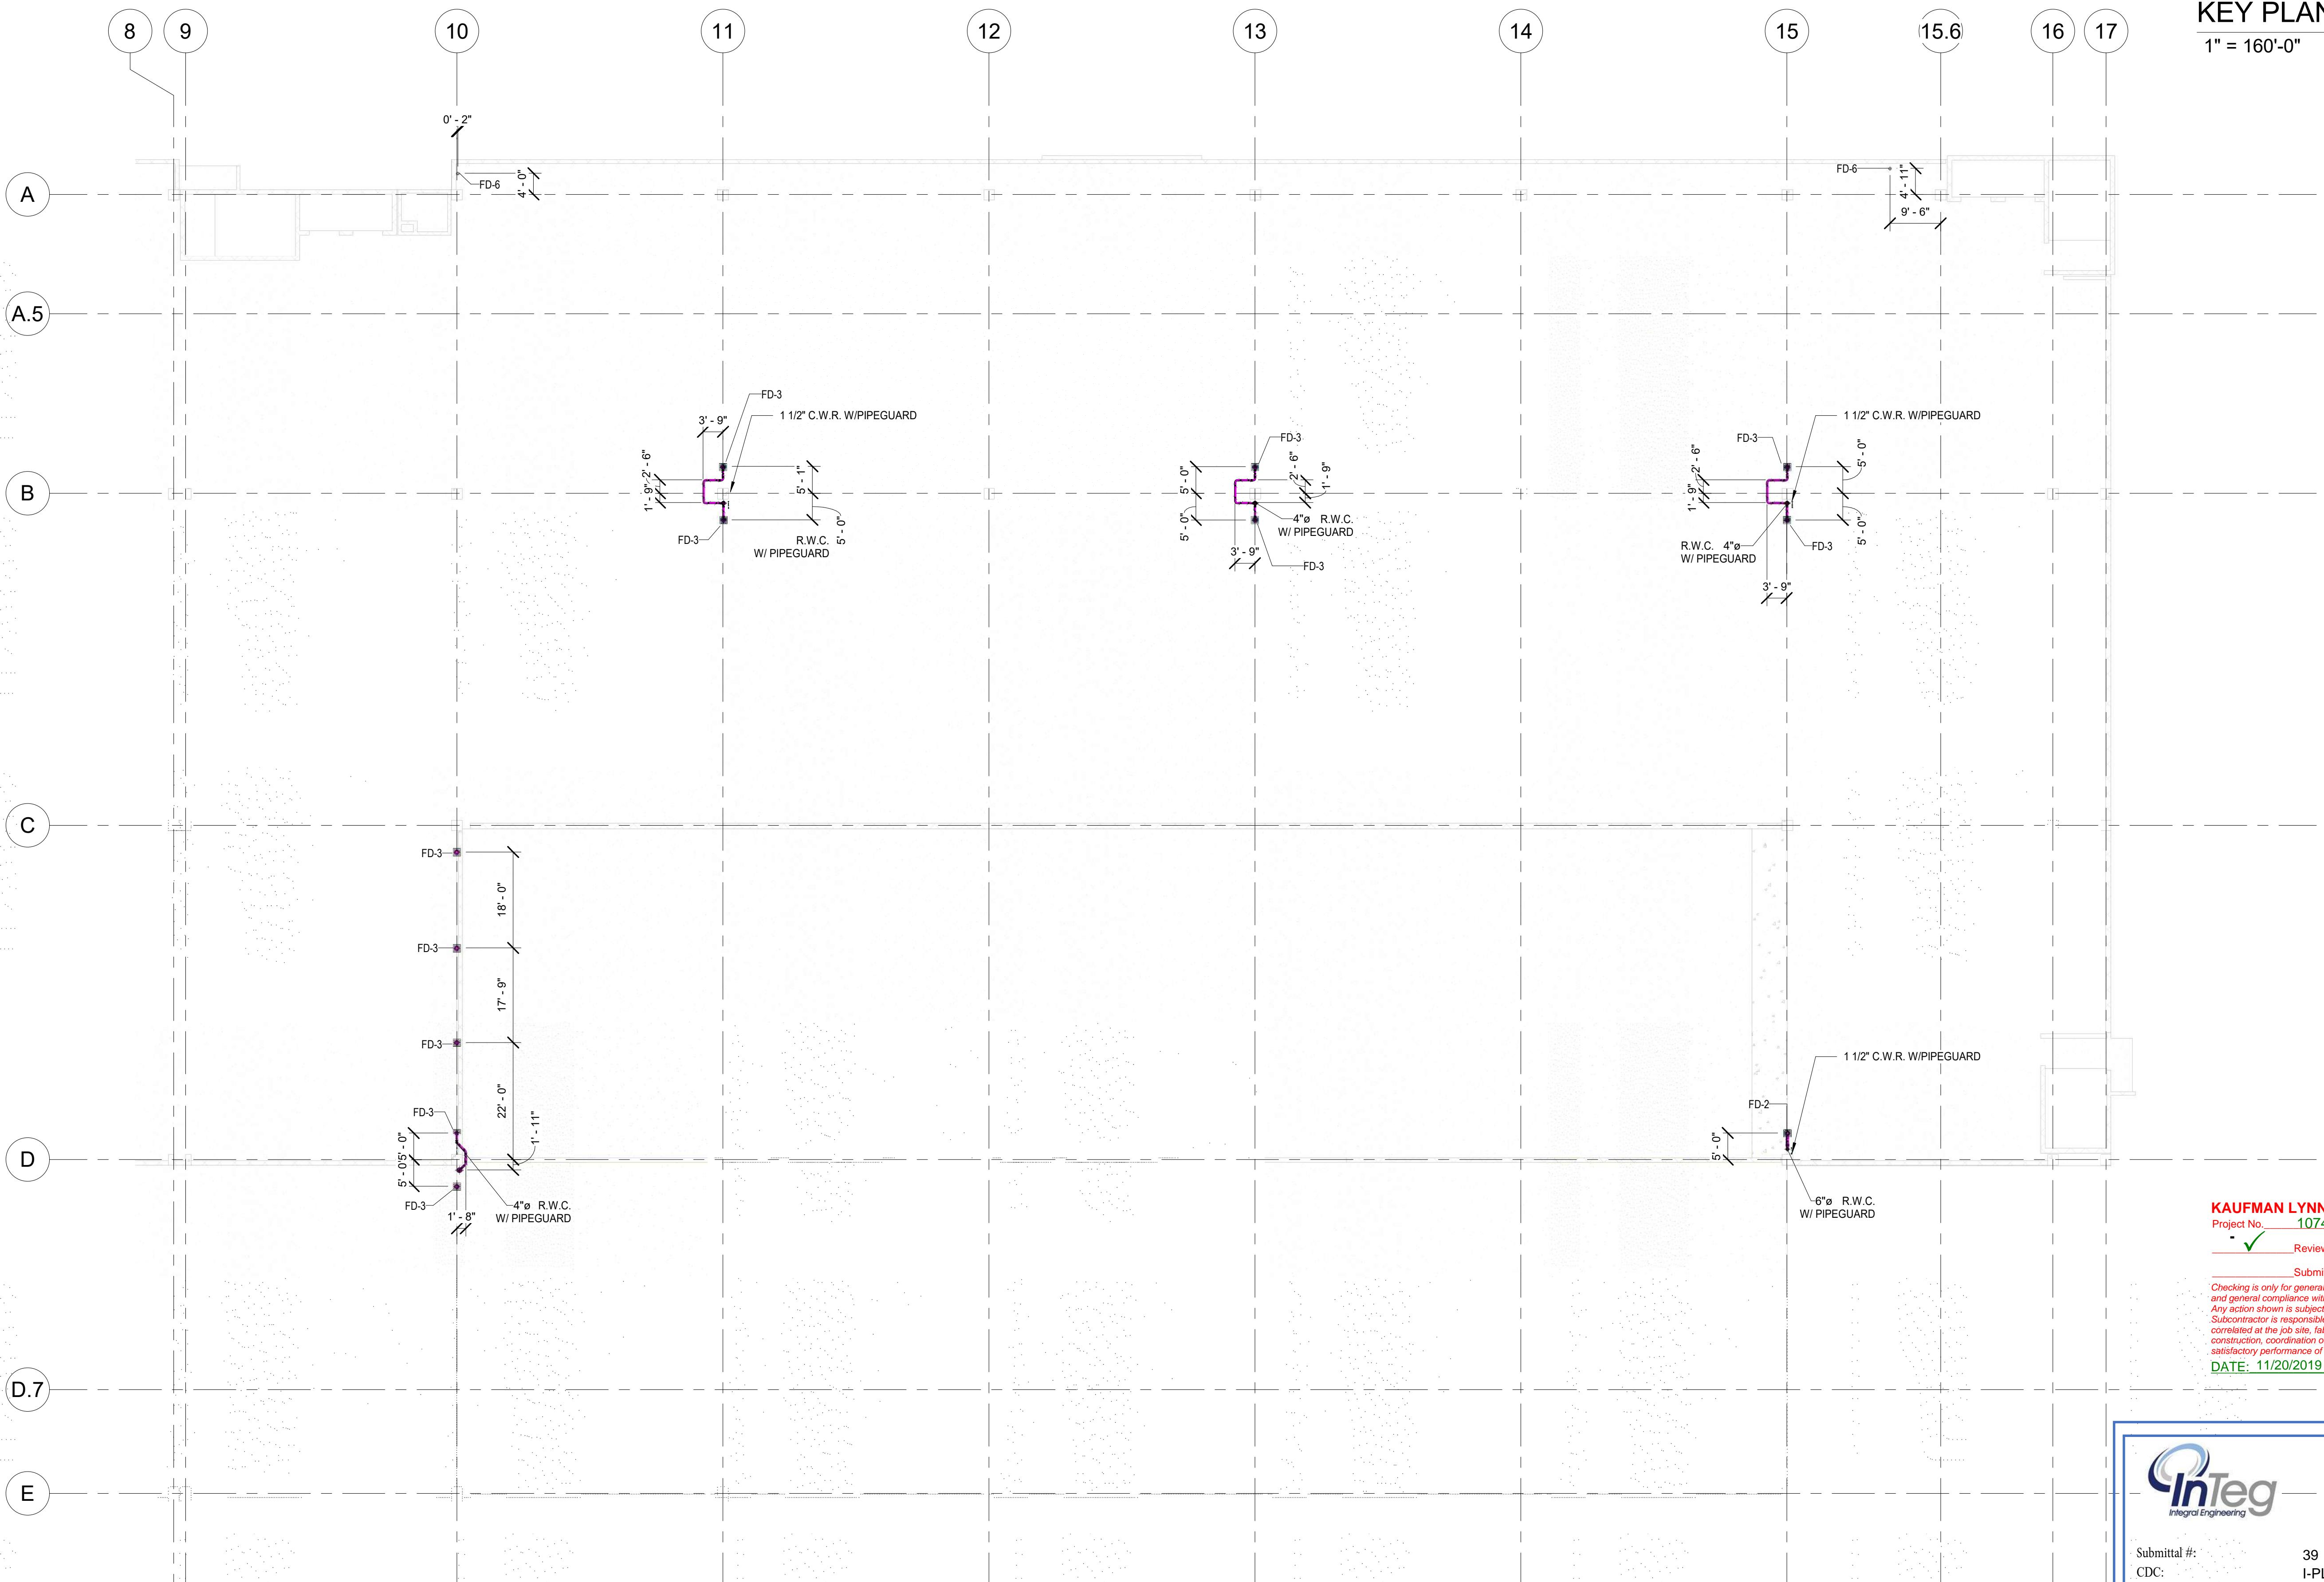

1 PARTIAL PLUMBING FIFTH LEVEL - EAST SIDE
1/16" = 1'-0"

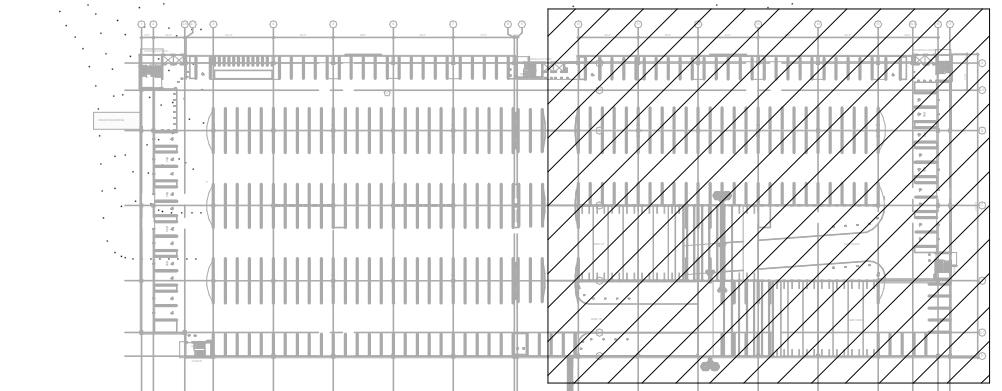

KEY PLAN - EAST SIDE

1" = 160'-0"

SHOP-DRAWING



NOMENCLATURE:

W= COOL WATER
CL= SANITARY DRAIN PIPE
CO= STORM DRAIN PIPE

ST (CO) STORM DRAIN PIPE
ST (CL) SANITARY DRAIN PIPE
W WATER PIPE

REFERENCE DRAWING:

PG-P-001/002 - 101A/101B
102A/102B - 103A/103B -
104A/104B - 105A/105B -
106A/107B - 601/602.

REV.	DATE	ISSUE FOR REVIEW	INTEG
4	11.08.2019	ISSUE FOR REVIEW	INTEG
3	10.28.2019	ISSUE FOR REVIEW	INTEG
2	09.24.2019	ISSUE FOR REVIEW	INTEG
1	08.19.2019	ISSUE FOR REVIEW	INTEG
0	08.14.2019	FREED FOR USE	INTEG

DEVELOPMENT	REVIEW
INTEG	INTEG

KAUFMAN LYNN CONSTRUCTION - SUBMITTAL

Project No. 1074

Submit No. #22.0500G-2

Reviewed Make Corrections Noted

Submittal Specified Item

Checking is only for general conformance with the design concept of the project and general compliance with the information given in the Contract Documents. Any action shown is subject to the requirements of the plans and specifications. Subcontractor is responsible for dimensions which shall be confirmed and correlated at the job site, fabrication processes and techniques sequences of construction and other factors which will be in accordance with that of all trades, and the satisfactory performance of his/her work.

DATE: 11/20/2019 BY: T. REEDER




Reviewed for general conformance to the contract documents. This review does not relieve the vendor of the responsibility of making the work conform to the plans and the FDOT Design Standards.

Submittal #: 39
CDC: I-PLUMBING-GGMTF-021919
Job #: 424
Reviewed by: EDUARDO PEREIRA
Date: 11/08/2019
Vendor: REVISION
Product: SHOP DRAWINGS.
Description:


LOCATED:
STATE OF FLORIDA / DEPARTMENT OF TRANSPORTATION
MIAMI-DADE
ROAD NO. SR 7 / FINANCIAL PROJECT ID 251684-6-52-01

CONTENT:
PARTIAL PLUMBING
PLAN - FIFTH LEVEL -
EAST SIDE

DATE: 08/16/19 SCALE: As indicated REVIEW: 4 PROJECT:
CODE: GG-P-010

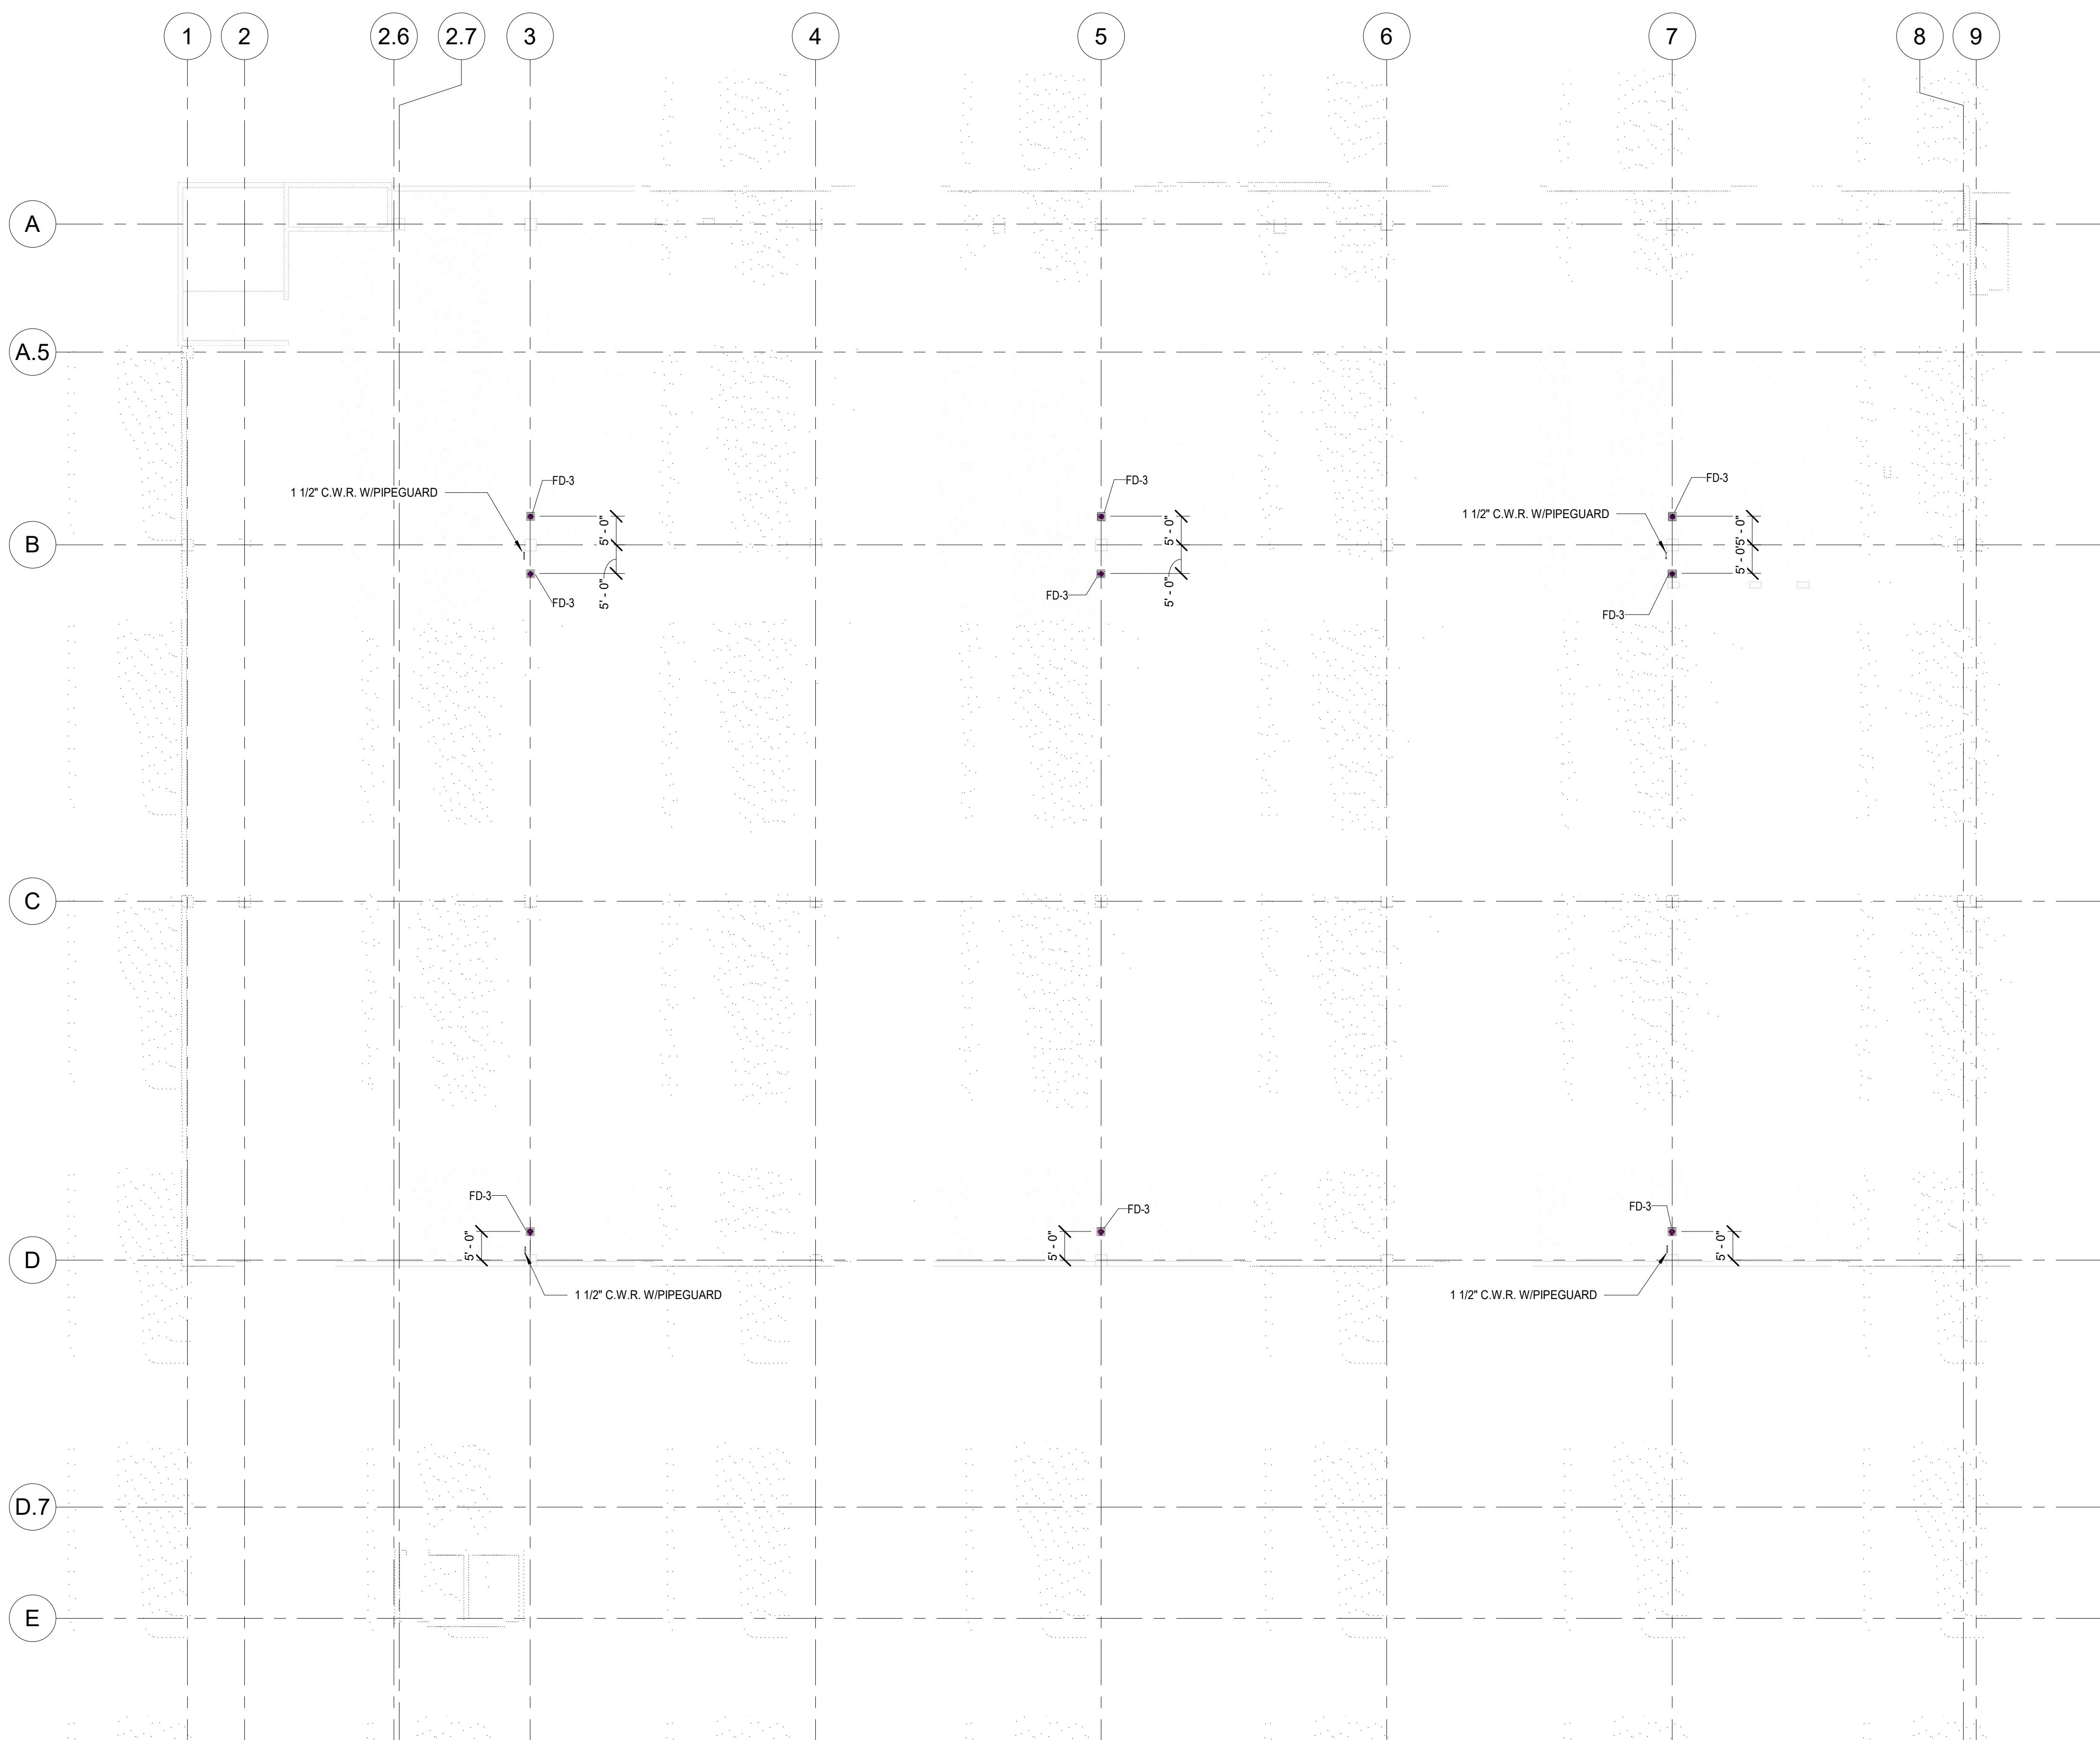

1 PARTIAL PLUMBING SIXTH LEVEL - WEST SIDE
1/16" = 1'-0"

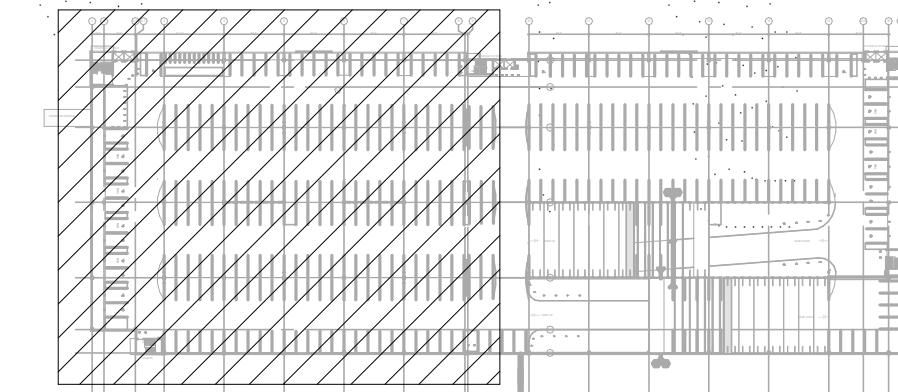

KEY PLAN - WEST SIDE

1" = 160'-0"

SHOP-DRAWING



NOMENCLATURE:

W= COOL WATER
CL= SANITARY DRAIN PIPE
CO= STORM DRAIN PIPE

ST (CO) STORM DRAIN PIPE
ST (CL) SANITARY DRAIN PIPE
W WATER PIPE

REFERENCE DRAWING:

PG-P-001/002 - 101A/101B
102A/102B - 103A/103B -
104A/104B - 105A/105B -
106A/107B - 601/602.

REV.	DATE	ISSUE FOR REVIEW	INTEG
4	11.08.2019	ISSUE FOR REVIEW	INTEG
3	10.28.2019	ISSUE FOR REVIEW	INTEG
2	09.24.2019	ISSUE FOR REVIEW	INTEG
1	08.13.2019	ISSUE FOR REVIEW	INTEG
0	08.13.2019	FREEDOM TO DESIGN	INTEG
		DESCRIPTION	APPROVED

DEVELOPMENT	REVIEW
INTEG	INTEG

KAUFMAN LYNN CONSTRUCTION - SUBMITTAL
Project No. 1074 Submittal No. #22 0500G-2

Reviewed Make Corrections Noted

Submit Specified Item
Checking is only for general conformance with the design concept of the project and general compliance with the information given in the Contract Documents. Any question shall be subject to the requirements of the plans and specifications. Subcontractor is responsible for dimensions which shall be confirmed and correlated at the job site, fabrication processes and techniques sequences of construction, coordination of his/her work with that of all trades, and the satisfactory performance of his/her work.

DATE: 11/20/2019 BY: T. REEDER



Reviewed for general conformance to the contract documents. This review does relieve the vendor of the responsibility of making the work conform to the plans and the FDOT Design Standards.


Submittal #: 39
CDC: I-PLUMBING-GGMTF-021919
Job #: 424
Reviewed by: EDUARDO PEREIRA
Date: 11/08/2019
Vendor: REVISION
Product: SHOP DRAWINGS.
Description:

LOCATED:
STATE OF FLORIDA / DEPARTMENT OF TRANSPORTATION
MIAMI-DADE
ROAD NO. SR 7 / FINANCIAL PROJECT ID 251684-6-52-01


CONTENT:

PARTIAL PLUMBING
PLAN - SIXTH LEVEL -
WEST SIDE

DATE:	SCALE:	REVIEW:	PROJECT:
08/16/19	As indicated	4	
CODE:			GG-P-011

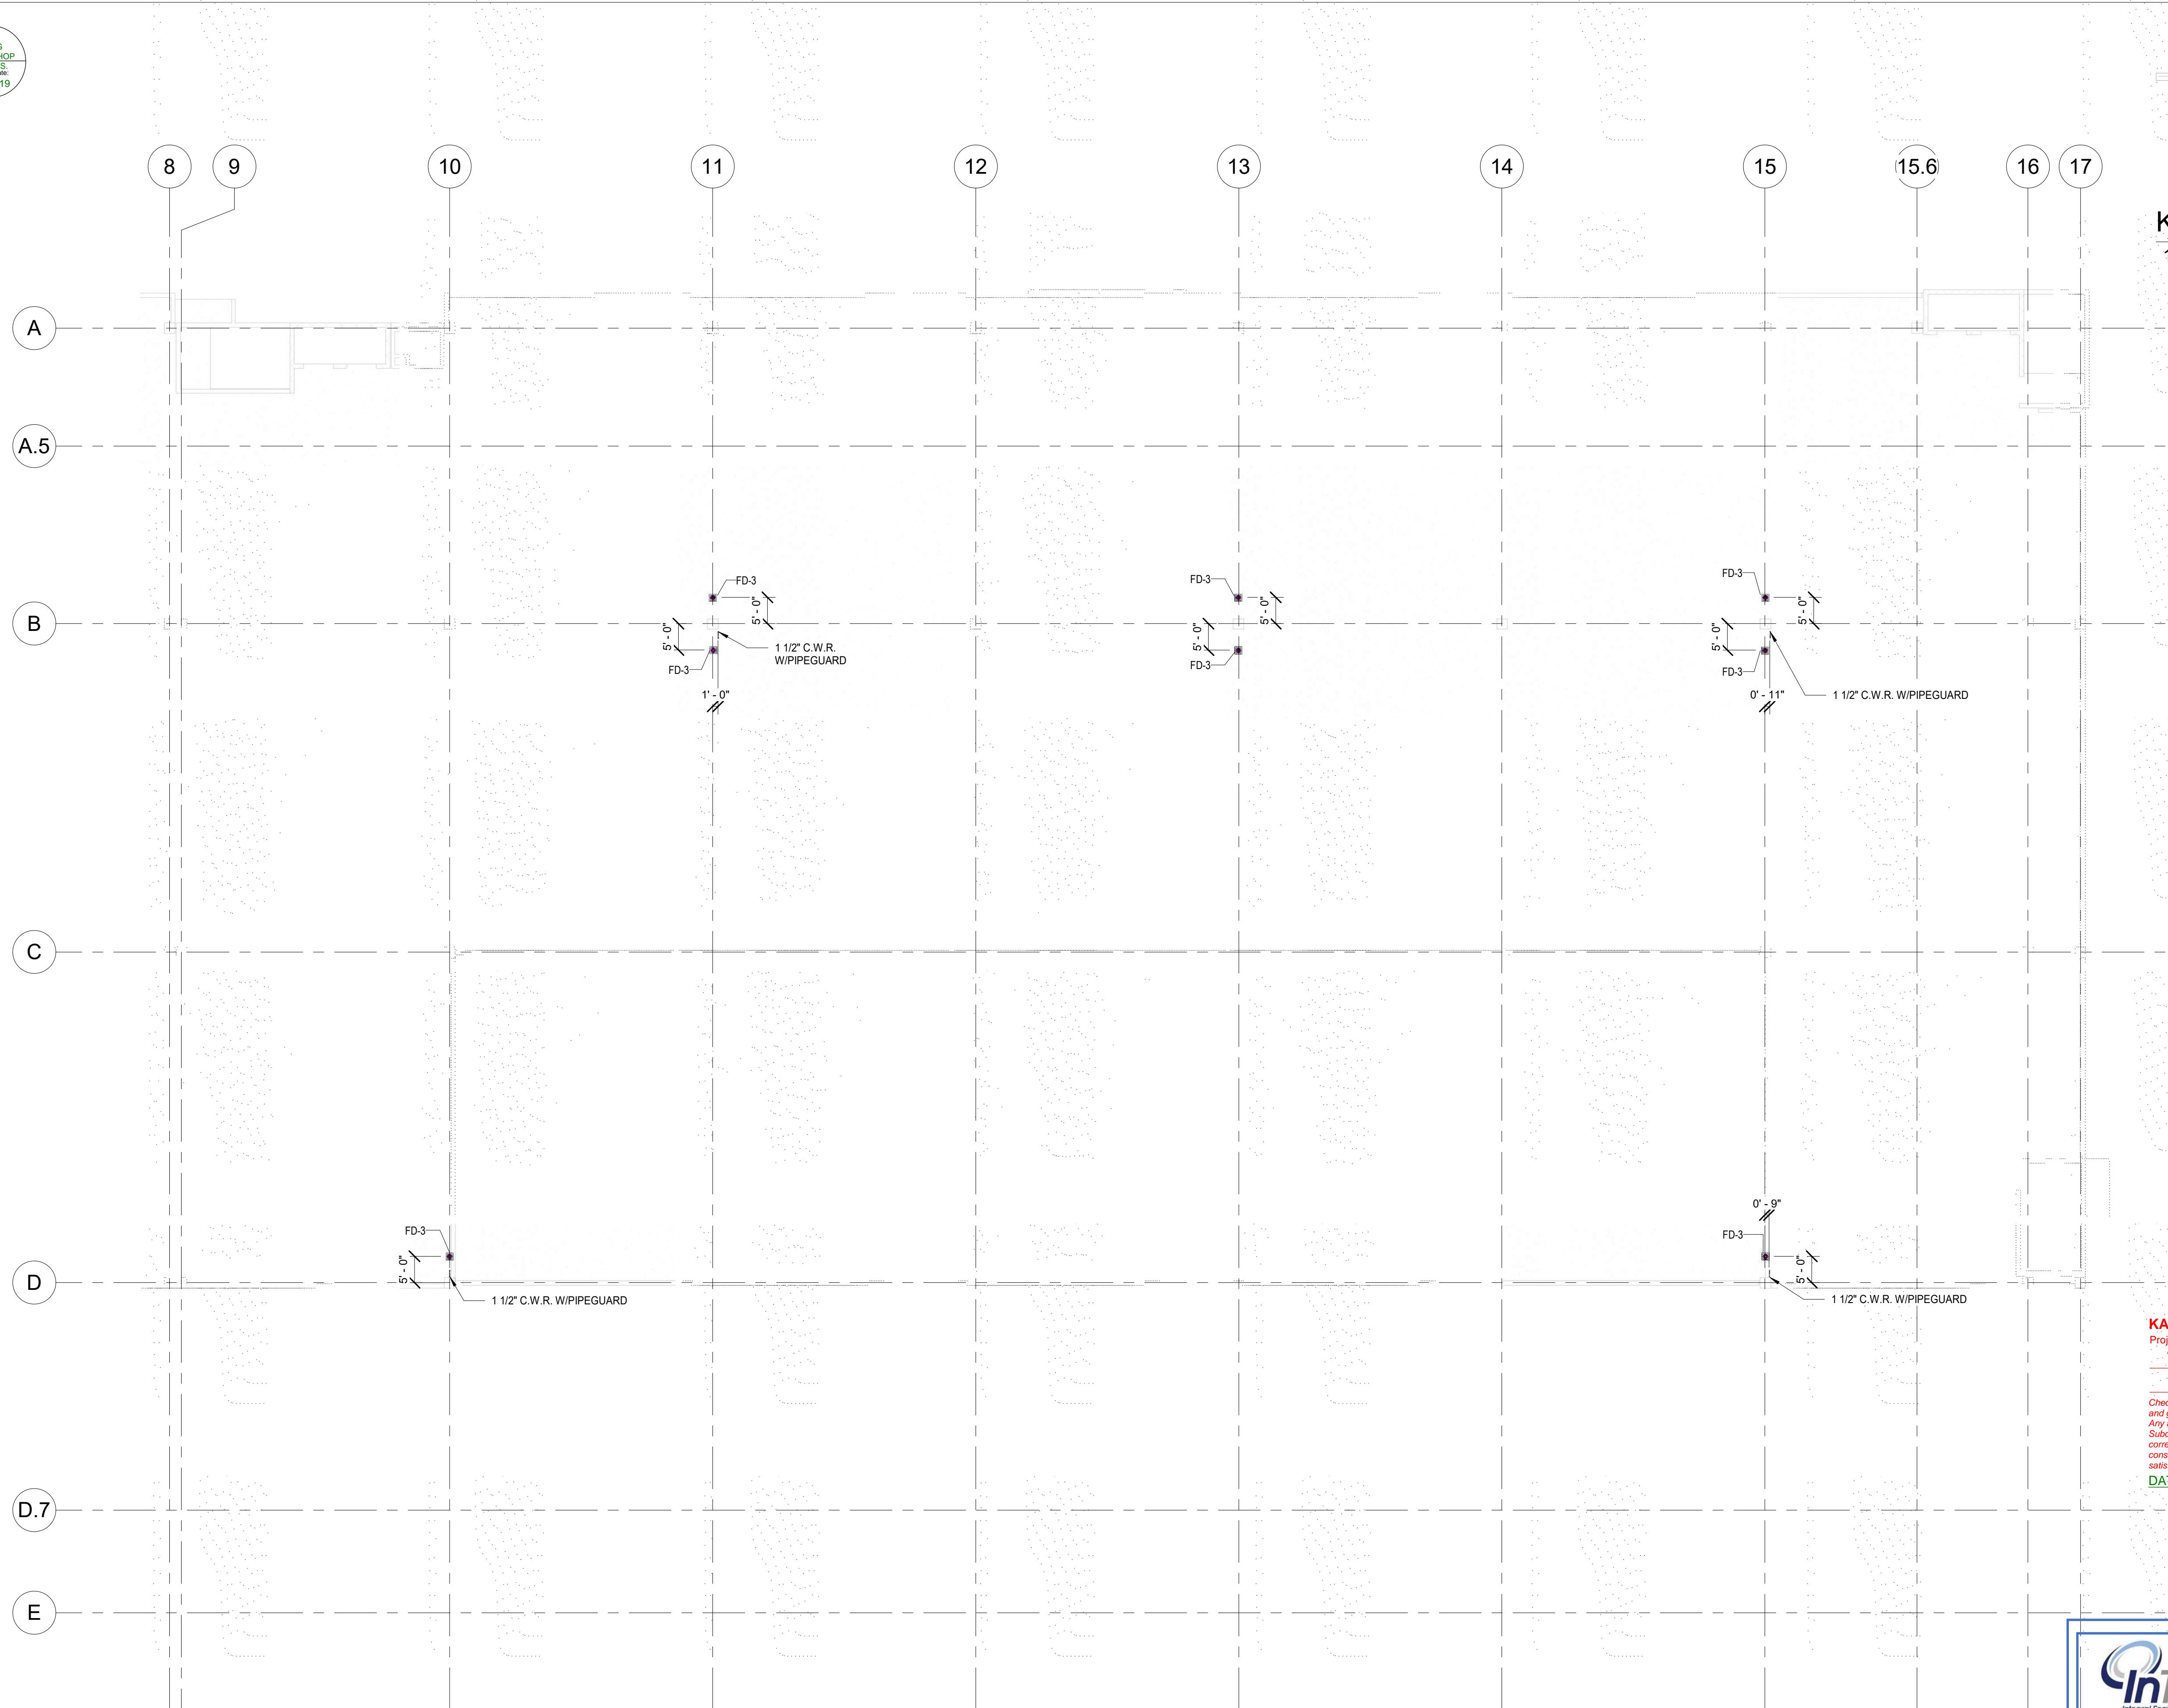

PARTIAL PLUMBING SIXTH LEVEL - EAST SIDE
1/16" = 1'-0"

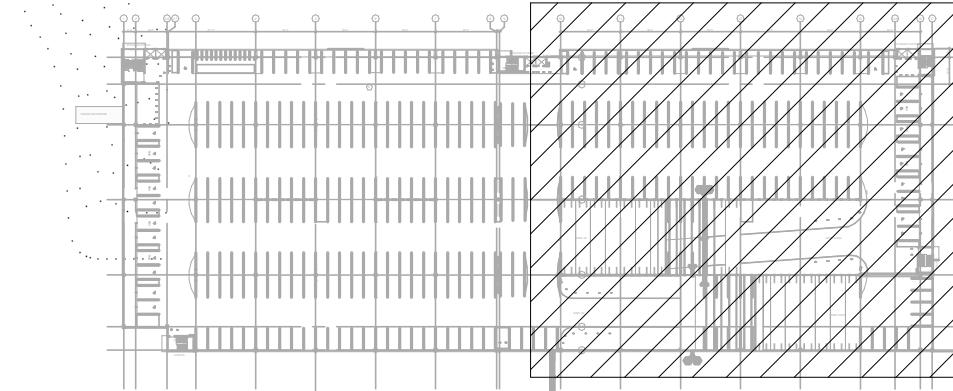

KEY PLAN - EAST SIDE

1" = 160'-0"

SHOP-DRAWING



NOMENCLATURE:

W= COOL WATER
CL= SANITARY DRAIN PIPE
CO= STORM DRAIN PIPE

ST (CO) STORM DRAIN PIPE
ST (CL) SANITARY DRAIN PIPE
W WATER PIPE

REFERENCE DRAWING:

PG-P-001/002 - 101A/101B
102A/102B - 103A/103B -
104A/104B - 105A/105B -
106A/107B - 601/602.

KAUFMAN LYNN CONSTRUCTION - SUBMITTAL

Project No. 1074 Submittal No. #22 0500G-2

Reviewed Make Corrections Noted

Submit Specified Item

Checking is only for general conformance with the design concept of the project and does not correlate with the information given in the Contract Documents. Any action shown is subject to the requirements of the plans and specifications. Subcontractor is responsible for dimensions which shall be confirmed and correlated at the job site, fabrication processes and techniques sequences of construction, and methods of installation work with that of all trades, and the satisfactory performance of his/her work.

DATE: 11/20/2019 BY: T. REEDER

4	11.08.2019	ISSUE FOR REVIEW	INTEG
3	10.28.2019	ISSUE FOR REVIEW	INTEG
2	09.24.2019	ISSUE FOR REVIEW	INTEG
1	06.10.2019	ISSUE FOR REVIEW	INTEG
0	08.10.2019	FREE FOR USE	INTEG
REV.	DATE	DESCRIPTION	APPROVED

DEVELOPMENT	REVIEW
INTEG	INTEG

PROJECT:
GOLDEN GLADES - PARKING GARAGE

PROPERTY OF:

LOCATED:
STATE OF FLORIDA / DEPARTMENT OF TRANSPORTATION
MIAMI-DADE
ROAD NO. SR 7 / FINANCIAL PROJECT ID 251684-6-52-01

CONTENT:

PARTIAL PLUMBING PLAN - SIXTH LEVEL - EAST SIDE



Reviewed for general conformance to the contract documents. This review does not relieve the vendor of the responsibility of making the work conform to the plans and the FDOT Design Standards.


Submittal #: 39
CDC: I-PLUMBING-GGMFT-021919
Job #: 424
Reviewed by: EDUARDO PEREIRA
Date: 11/08/2019
Vendor: REVISION
Product: SHOP DRAWINGS.
Description:

DATE: 08/16/19	SCALE: As indicated	REVIEW: 4	PROJECT:
CODE: GG-P-012			


The logo for InTeq, featuring a stylized blue and grey swoosh graphic followed by the word "InTeq" in a bold, sans-serif font.

Reviewed for general conformance to the contract documents. This review does relieve the vendor of the responsibility of making the work conform to the plans and the **FDOT Design Standards**.


Submittal #:	39
CDC:	I-PLUMBING-GGMTF-021919
Job #:	424
Reviewed by:	EDUARDO PEREIRA
Date:	11/08/2019
Vendor:	REVISION
Product	SHOP DRAWINGS.
Description:	

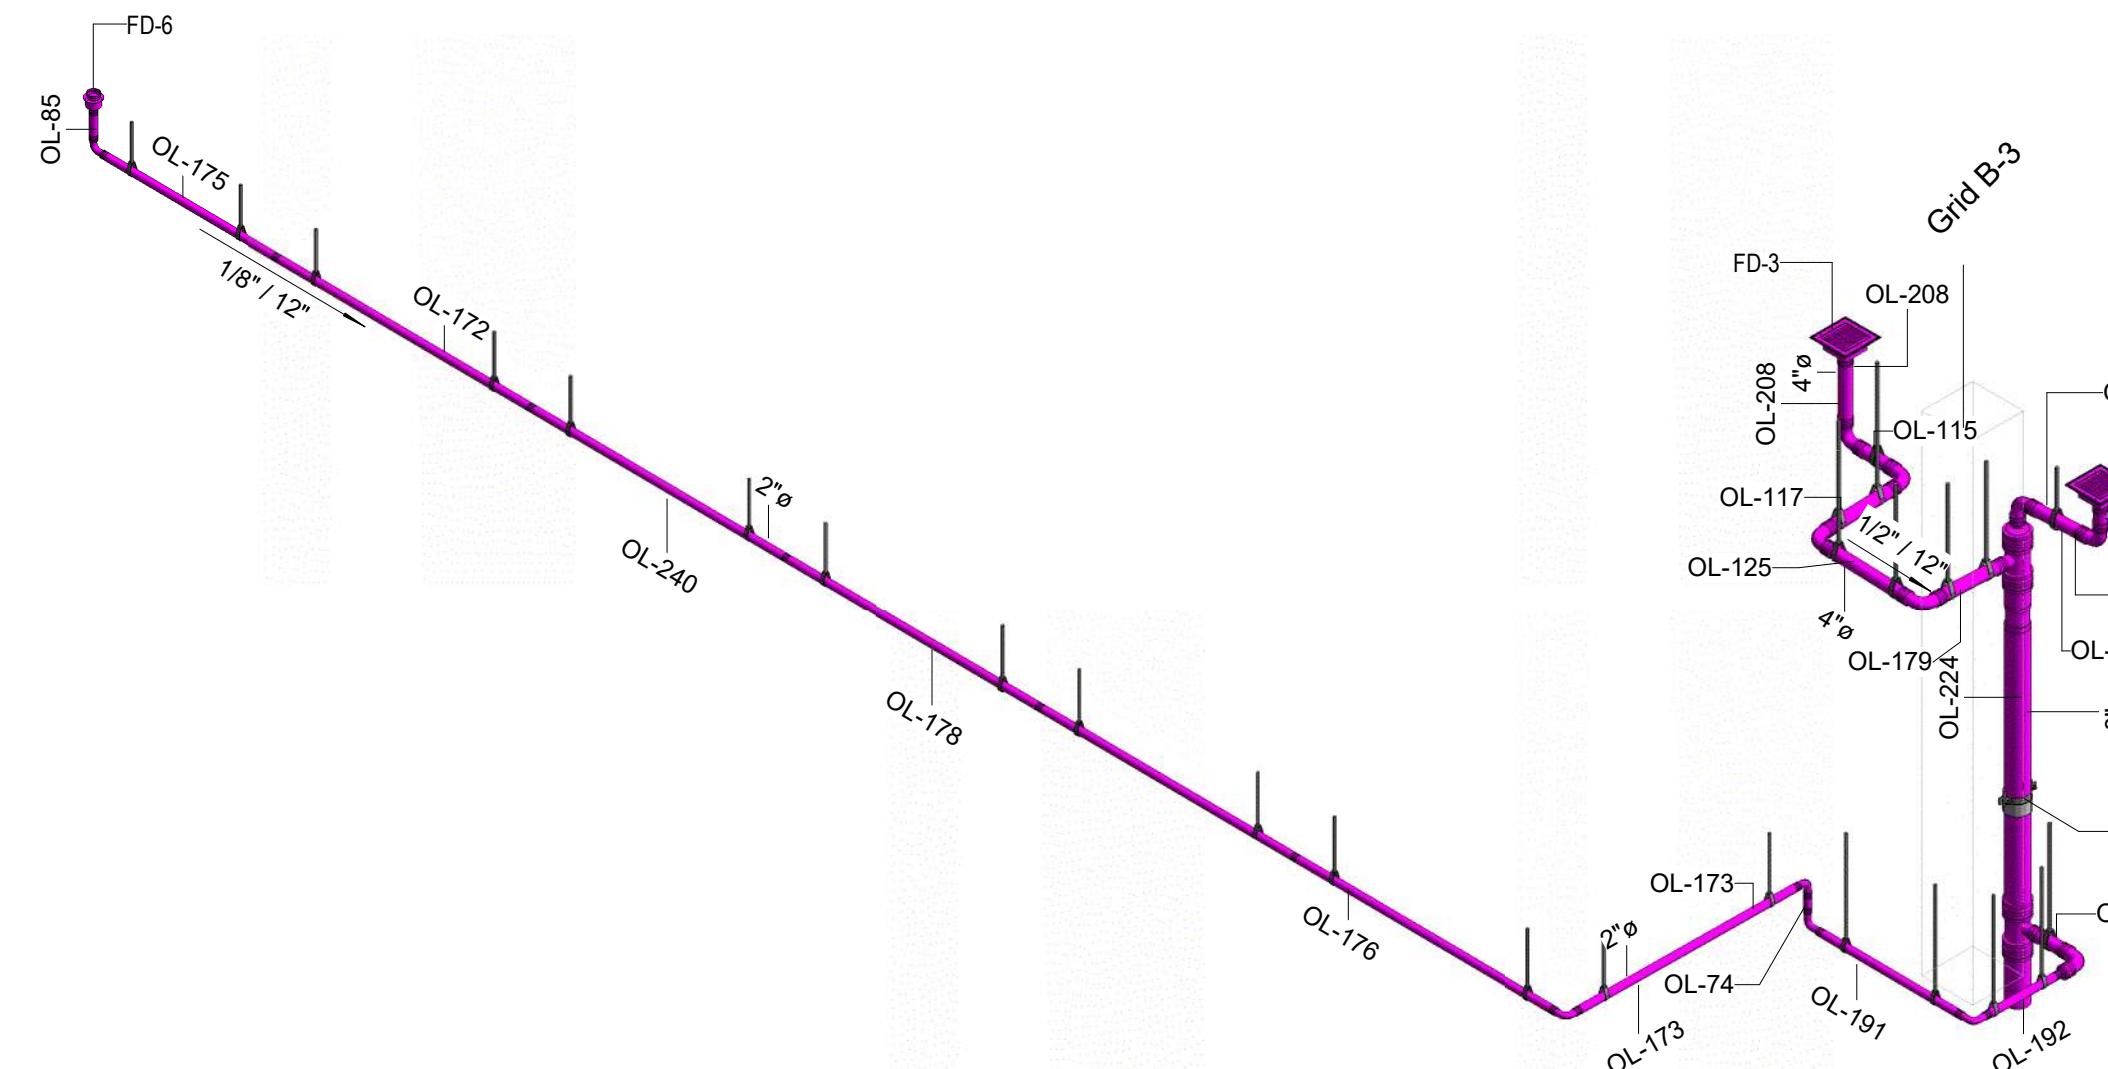


CO-ENLARGE

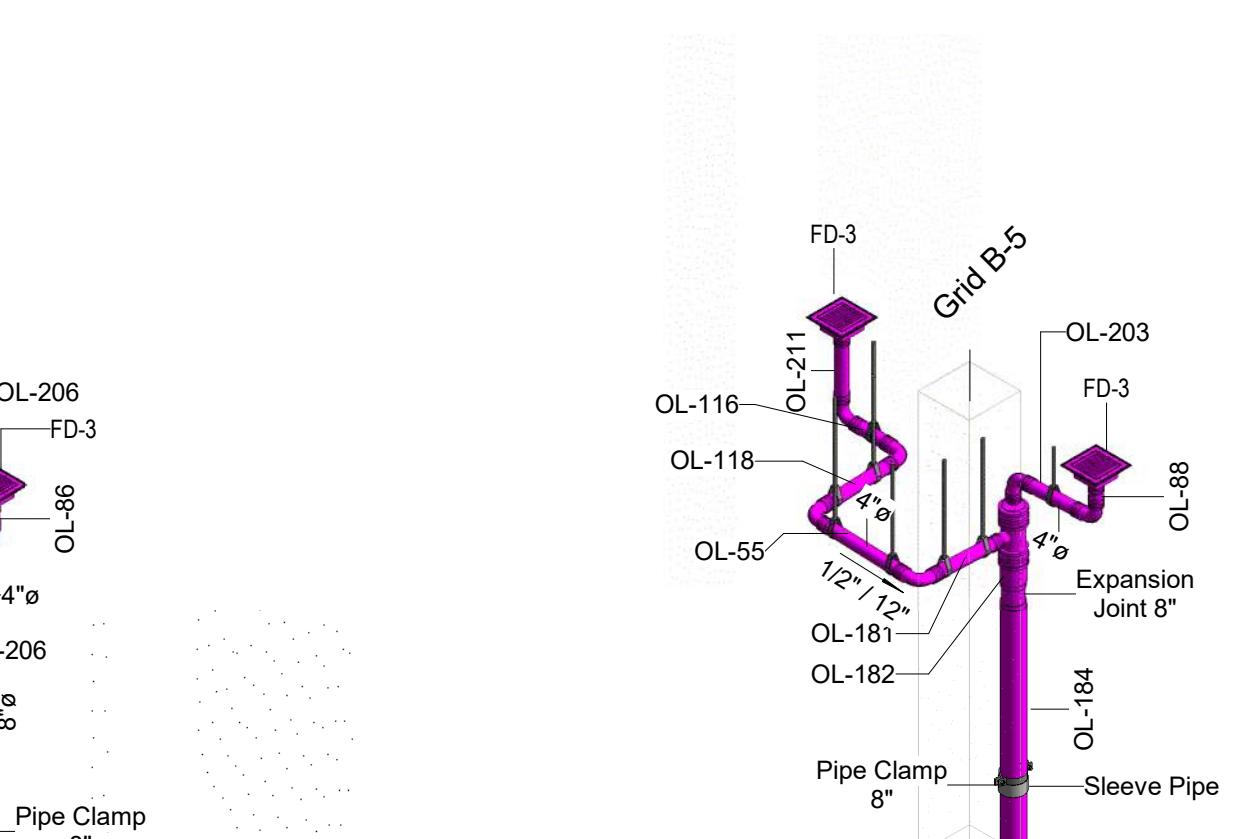


CO-ENLARGE 2

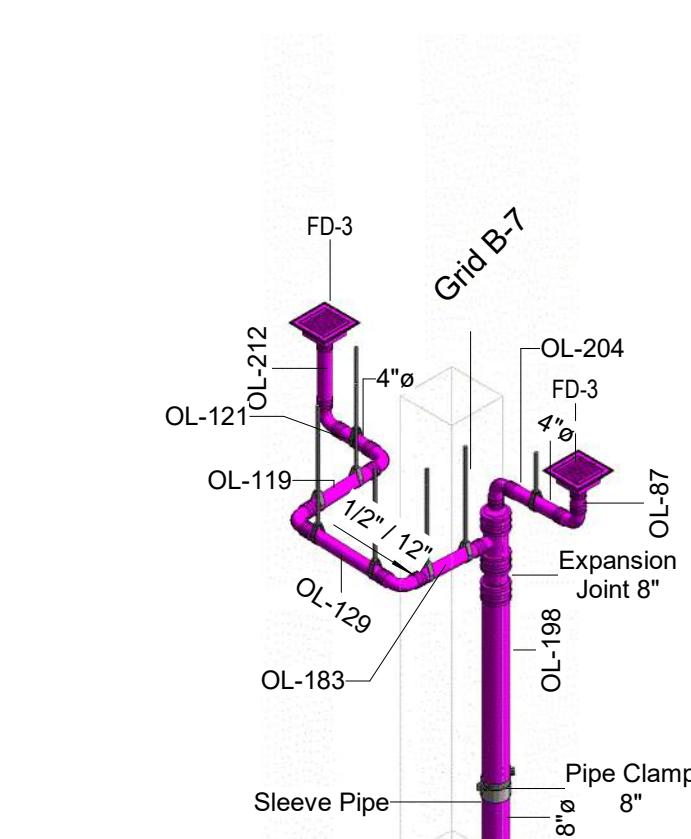


CO-ENLARGE 3

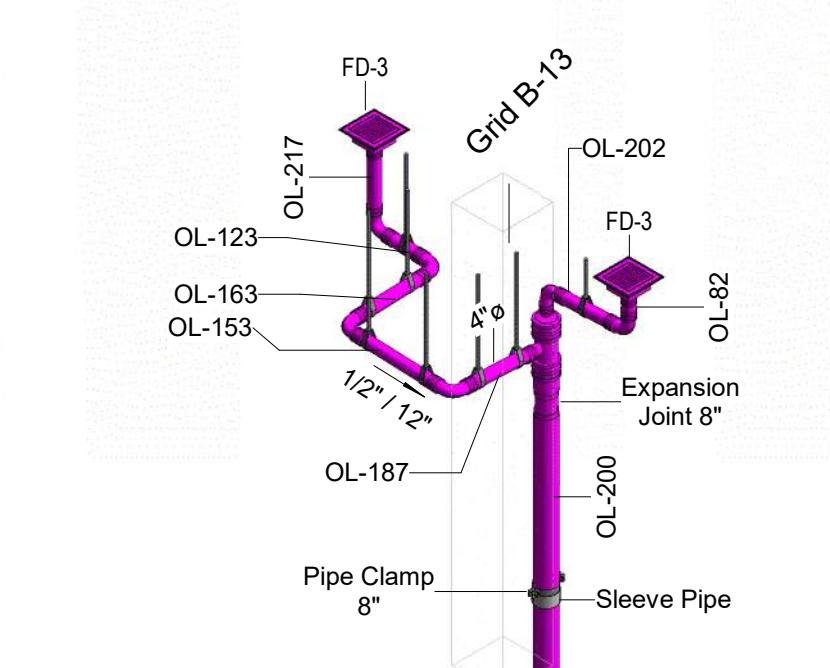

CO-ENLARGE 5

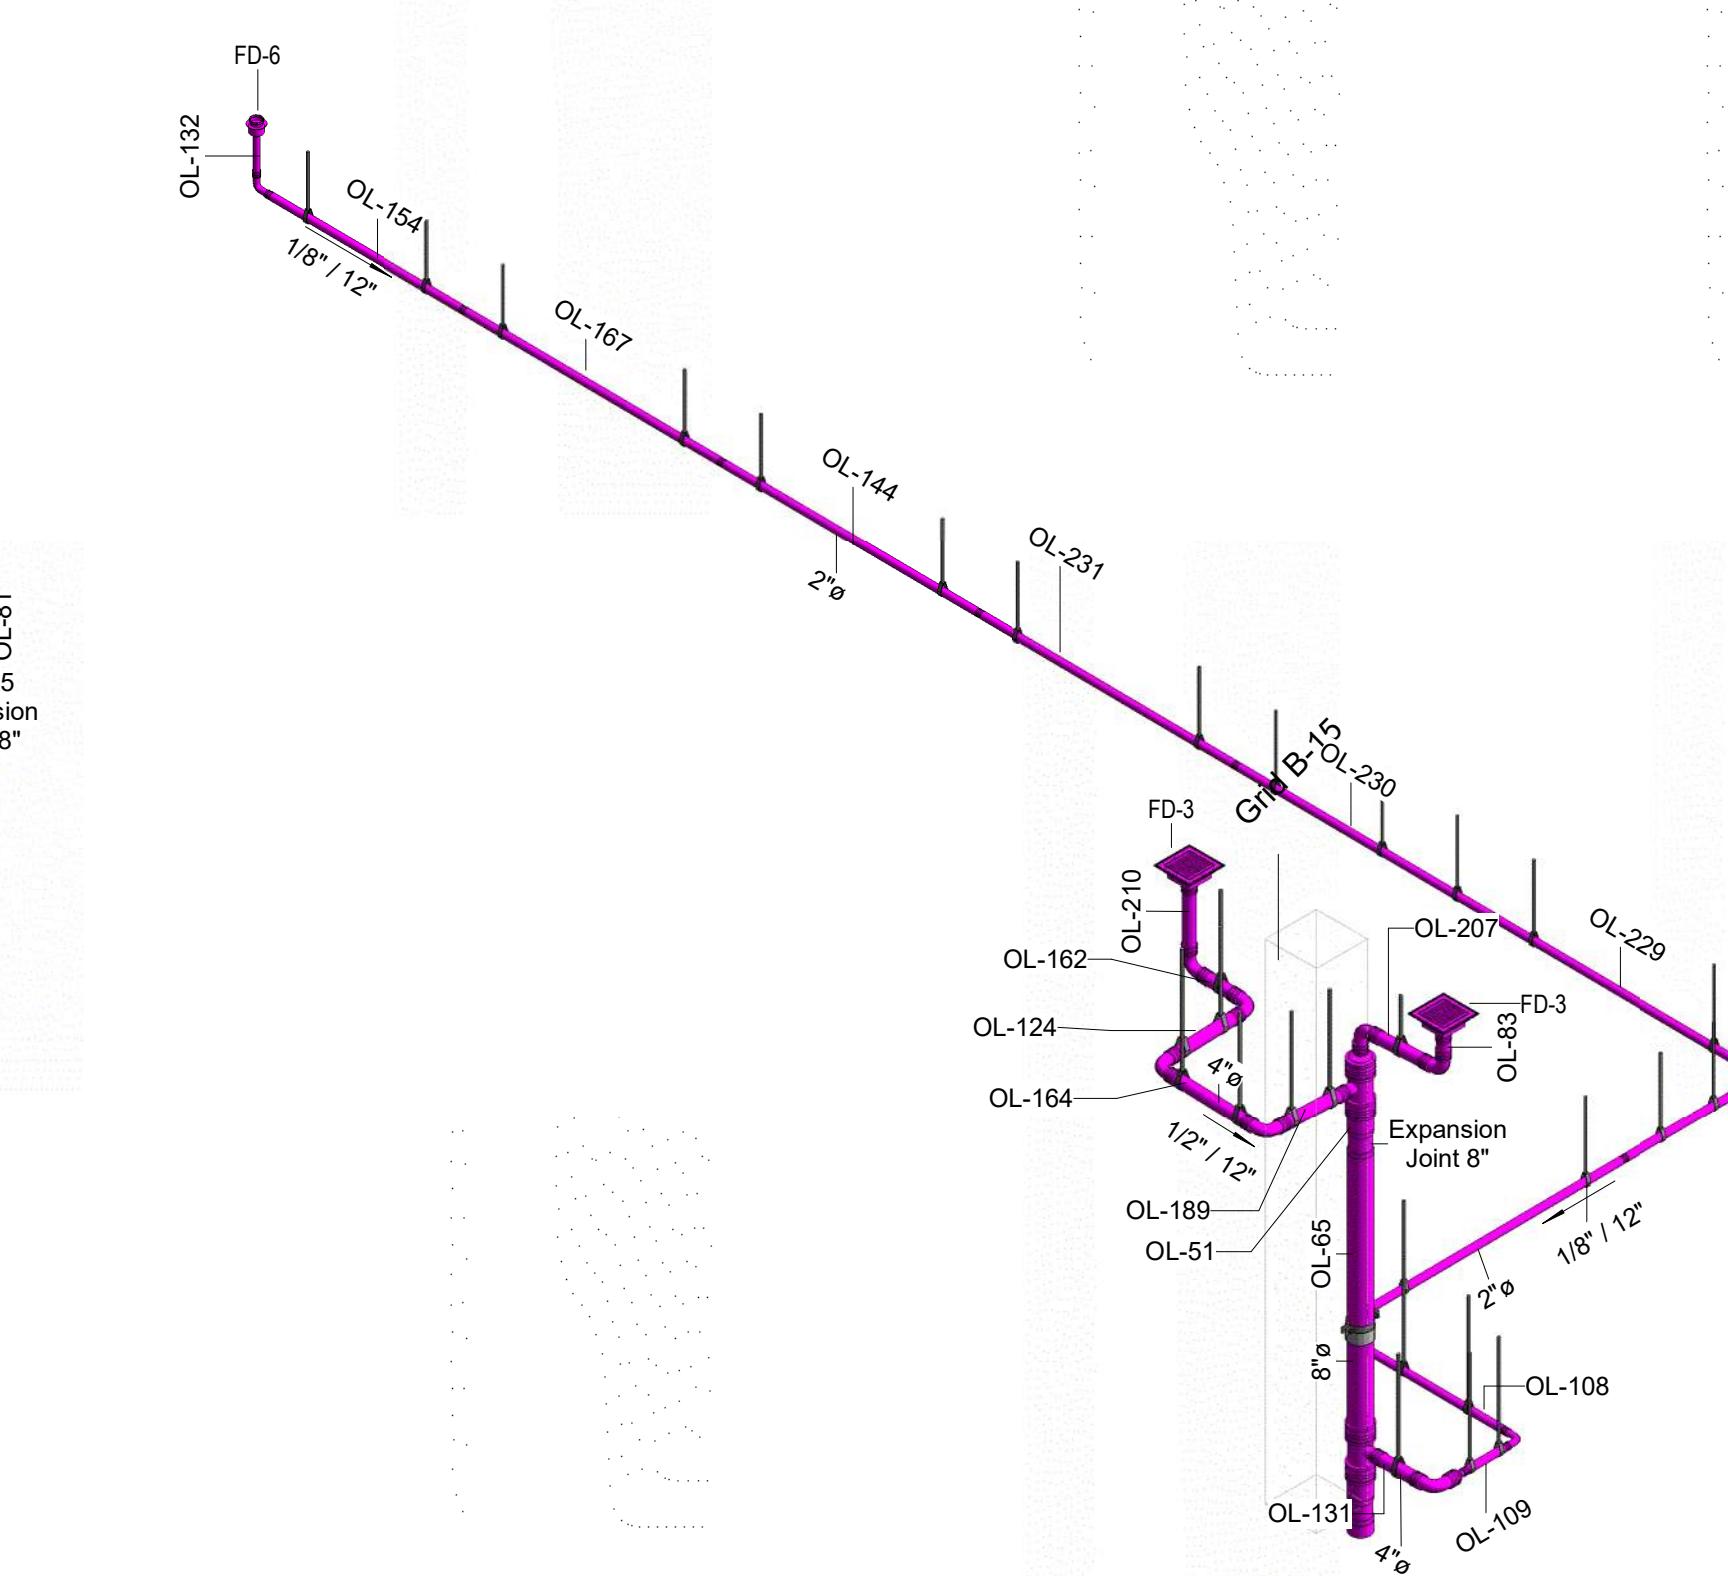

CO-ENLARGE 6

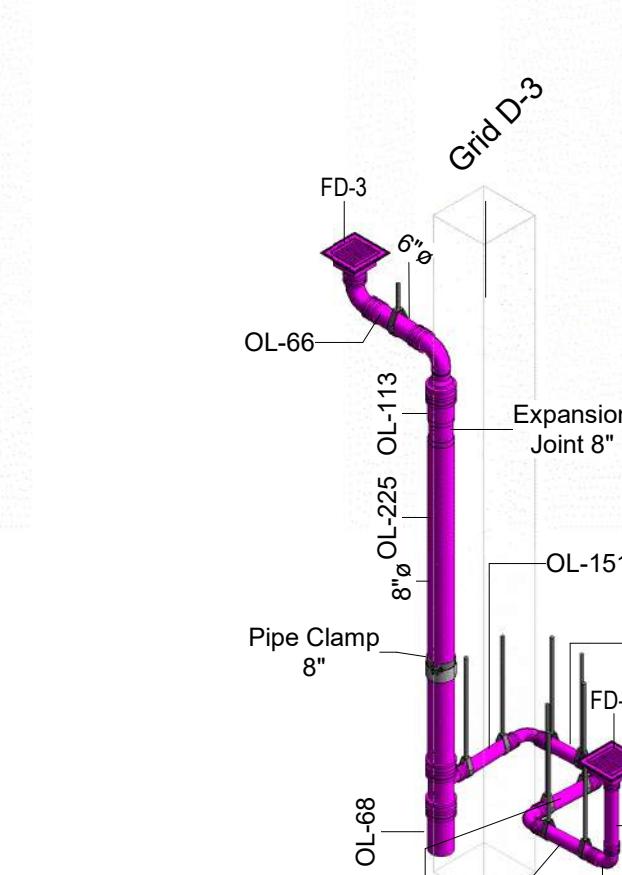

CO-ENLARGE 7

KAUFMAN LYNN CONSTRUCTION - SUBMITTAL	
Project No.	1074
Submittal No.	#22 0500G-2
<input checked="" type="checkbox"/> Reviewed	Make Corrections Noted
Submit Specified Item	
<p><i>Checking is only for general conformance with the design concept of the project and general compliance with the information given in the Contract Documents. Any action shown is subject to the requirements of the plans and specifications. Subcontractor is responsible for dimensions which shall be confirmed and correlated at the job site, fabrication processes and techniques sequences of construction, coordination of his/her work with that of all trades, and the satisfactory performance of his/her work.</i></p>	
DATE: 11/20/2019 BY: T. REEDER	

SHOP-DRAWING



NOMENCLATURE


W= COOL WATER
CL= SANITARY DRAIN PIPE
CO= STORM DRAIN PIPE


 ST (CO) STORM DRAIN PIPE
 ST (CL) SANITARY DRAIN PIPE

WATER PIPE


PG-P-001/002 - 101A/101B
102A/102B - 103A/103B -
104A/104B - 105A/105B -
106A/107B - 601/602

4	11.08.2019	ISSUE FOR REVIEW	INTEG
3	10.28.2019	ISSUE FOR REVIEW	INTEG
2	09.24.2019	ISSUE FOR REVIEW	INTEG
1	08.27.2019	ISSUE FOR REVIEW	INTEG
0	08.16.2019	FIRST ISSUE	INTEG
REV.	DATE	DESCRIPTION	APPROVED
DEVELOPMENT		REVIEW	
INTEG		INTEG	
PROJECT:			
GOLDEN GLADES - PARKING GARAGE			
PROPERTY OF:			
LOCATED: STATE OF FLORIDA / DEPARTMENT OF TRANSPORTATION MIAMI-DADE ROAD NO. SR 7 / FINANCIAL PROJECT ID 251684-6-52-01			
CONTENT:			
STORM PIPE - CO ENLARGE 3D VIEW			
DATE: 08/16/19	SCALE:	REVIEW: 4	PROJECT:
CODE: GG-P-014			

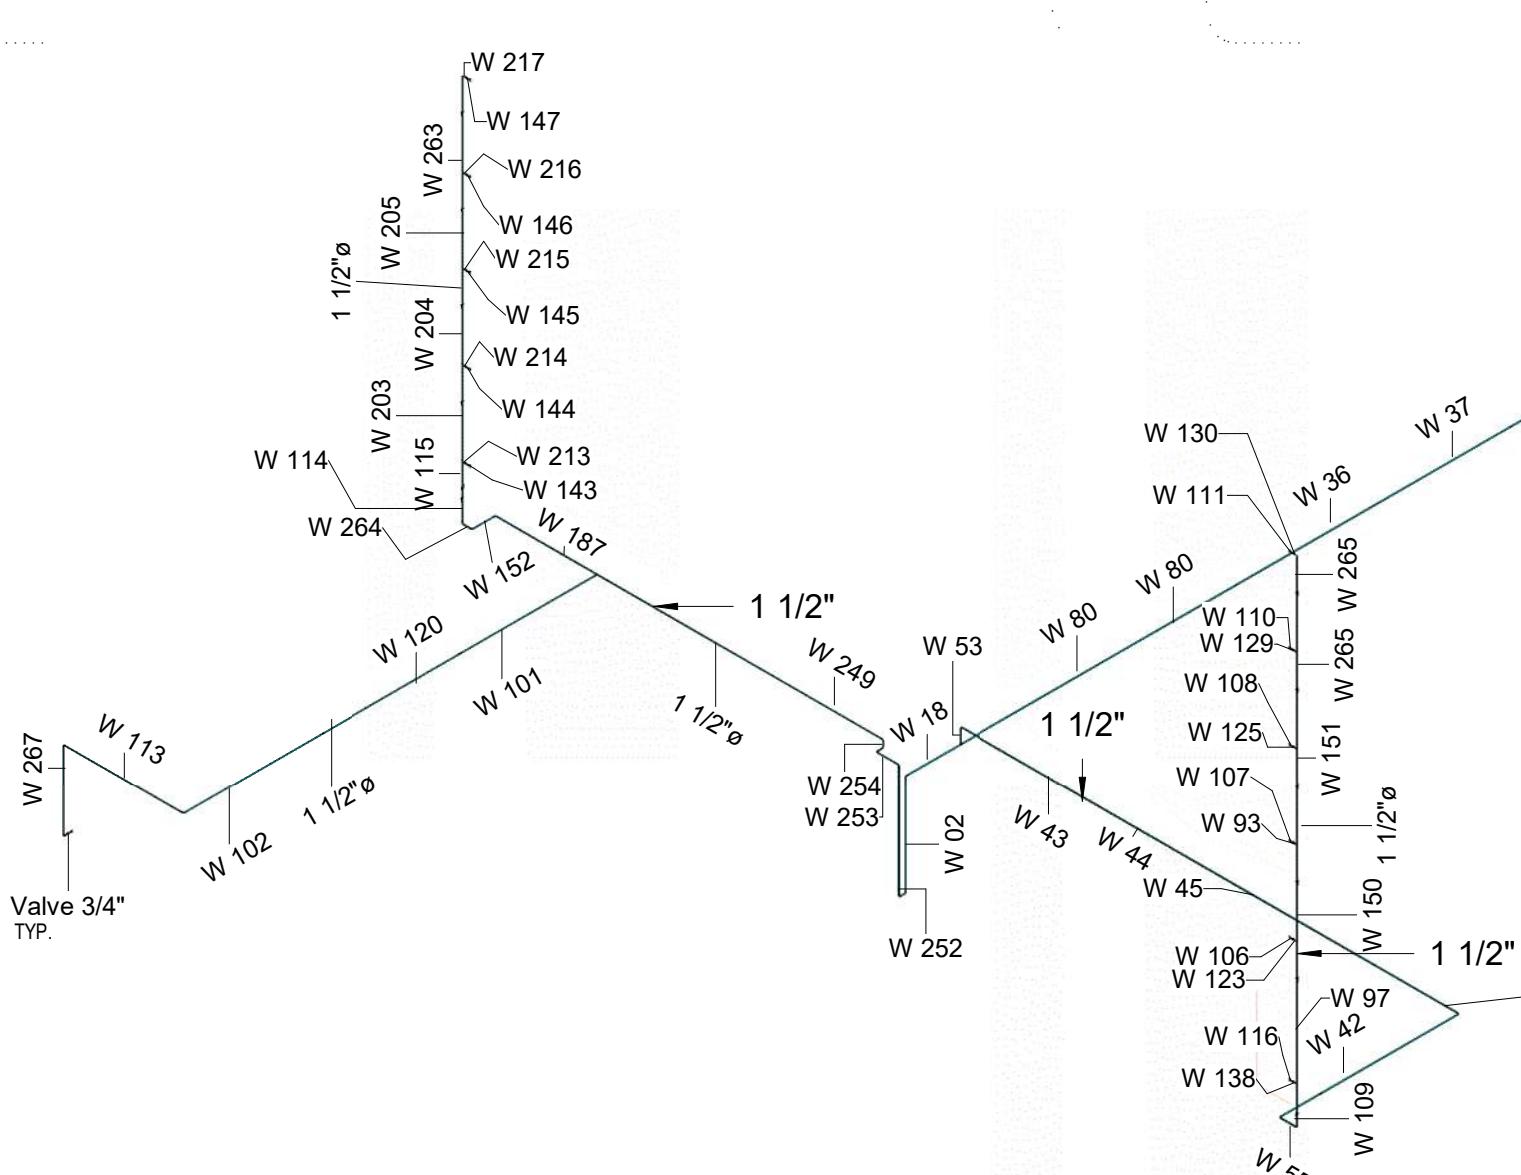


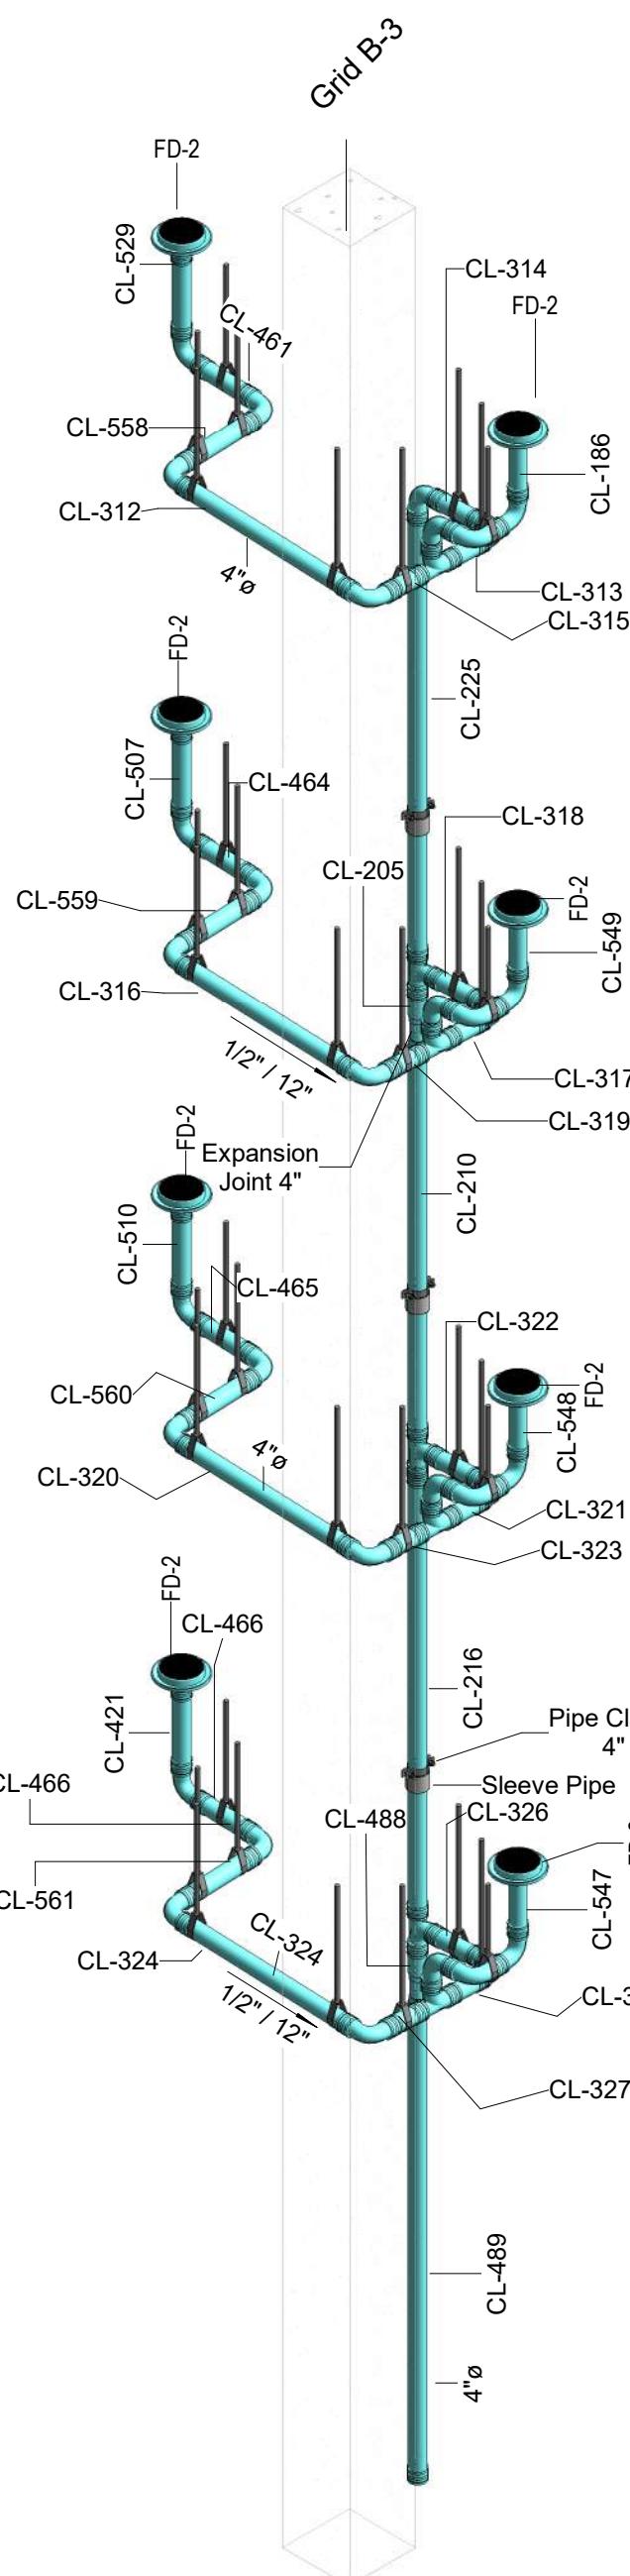


CL-ENLARGE 1

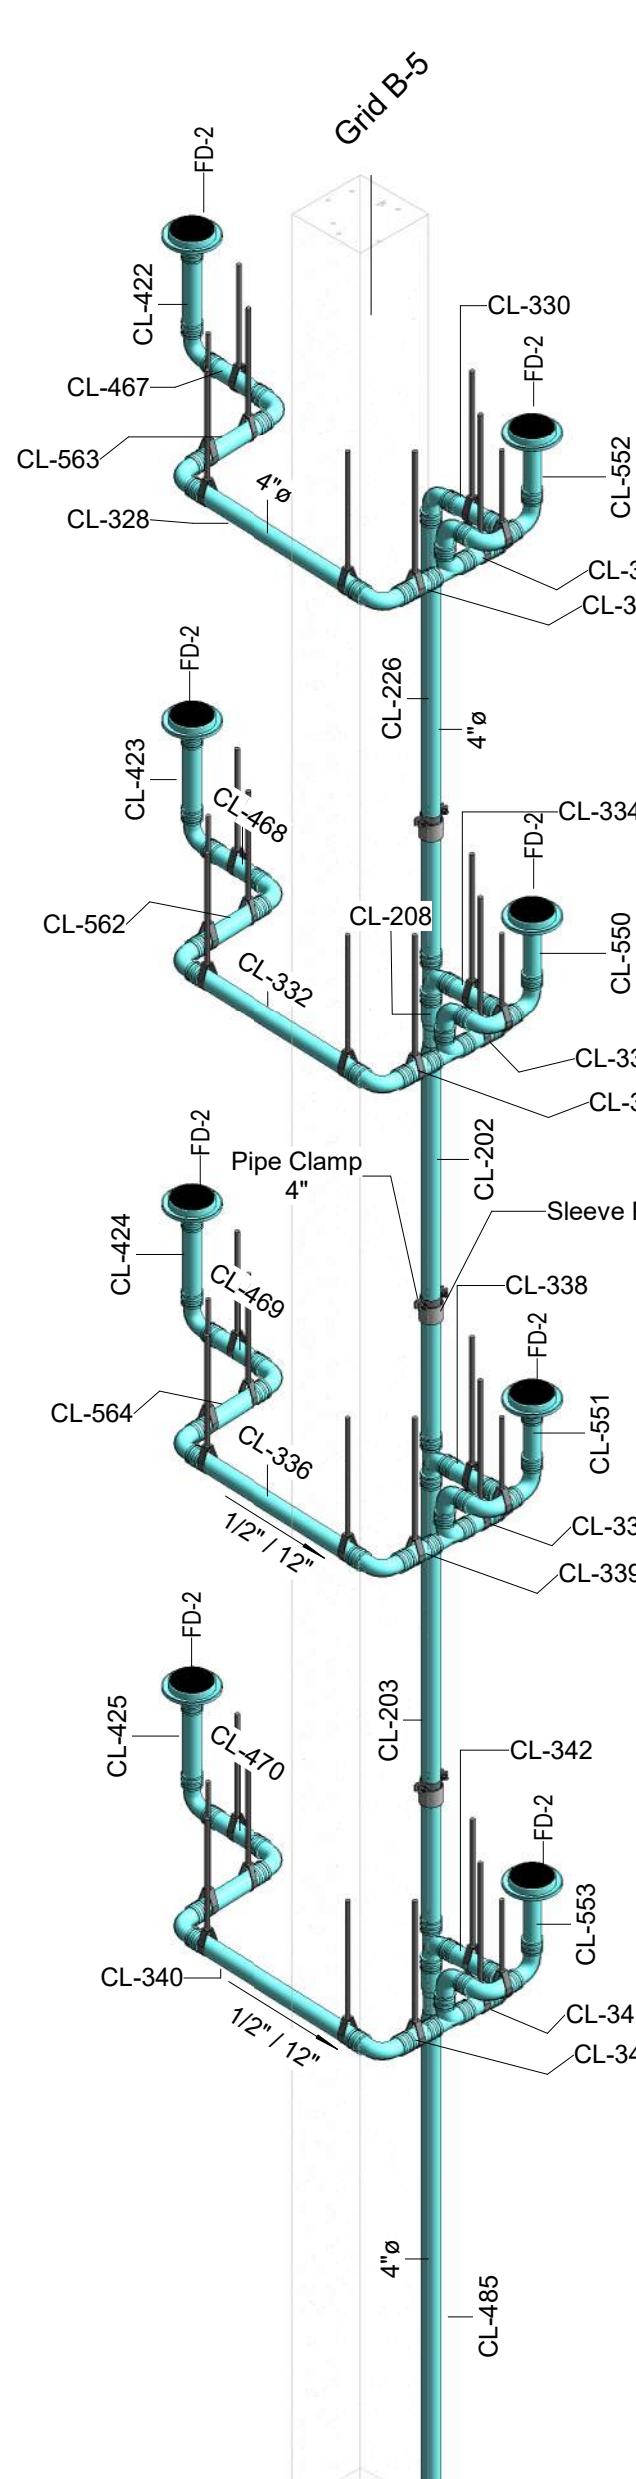


CL-ENLARGE 2

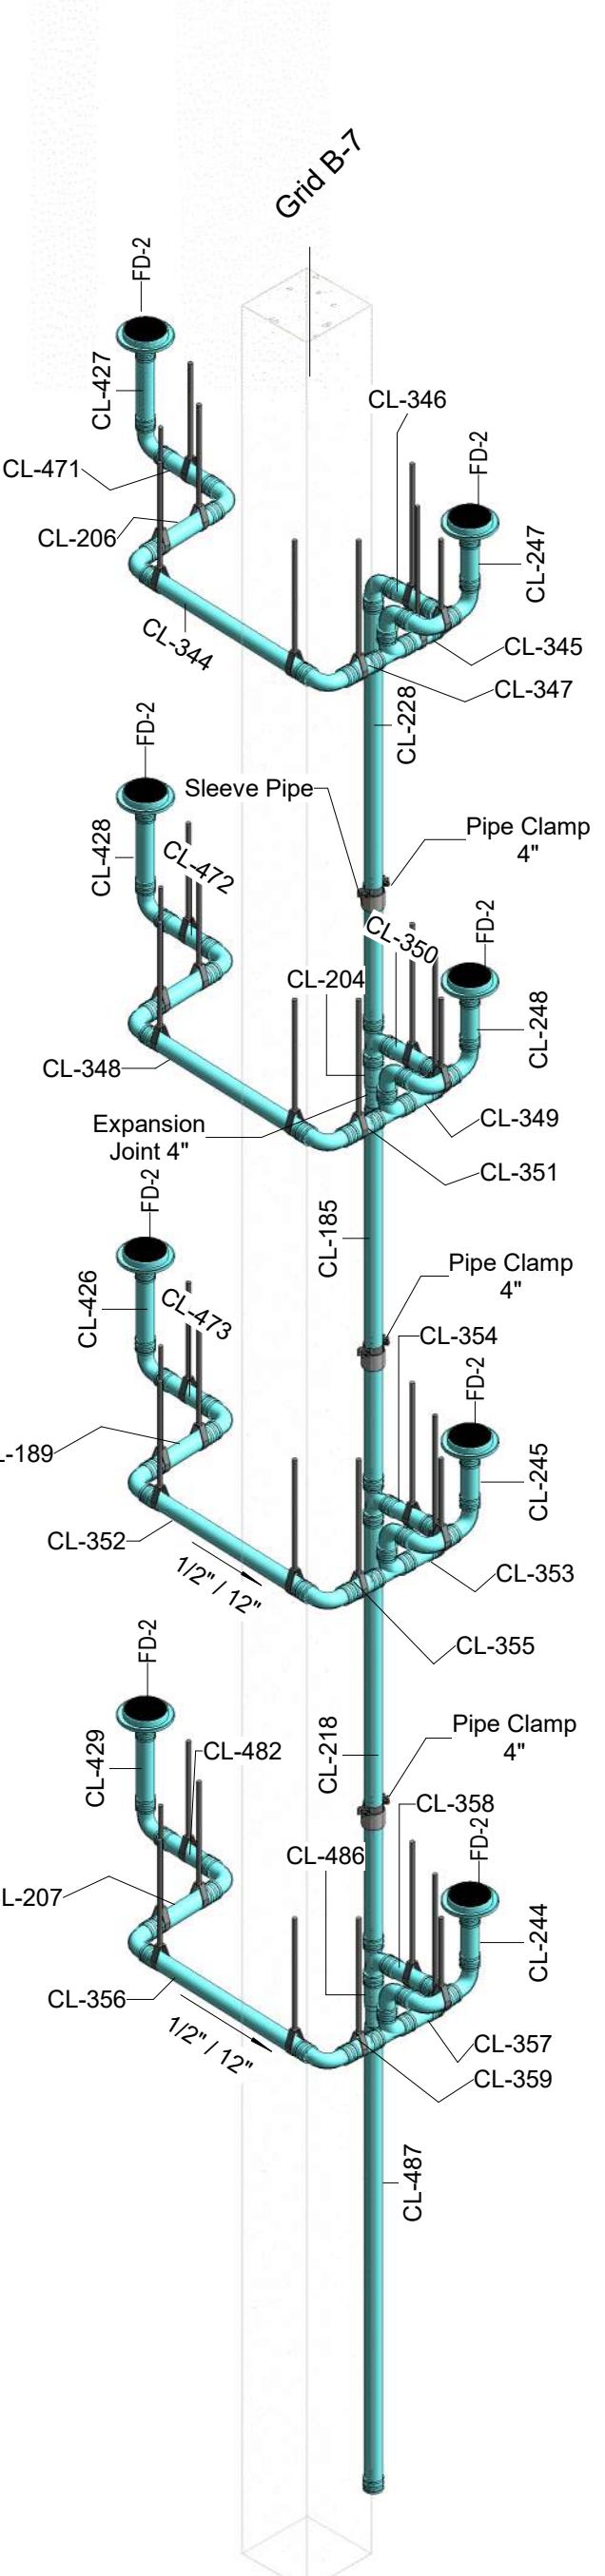


CL-ENLARGE 3

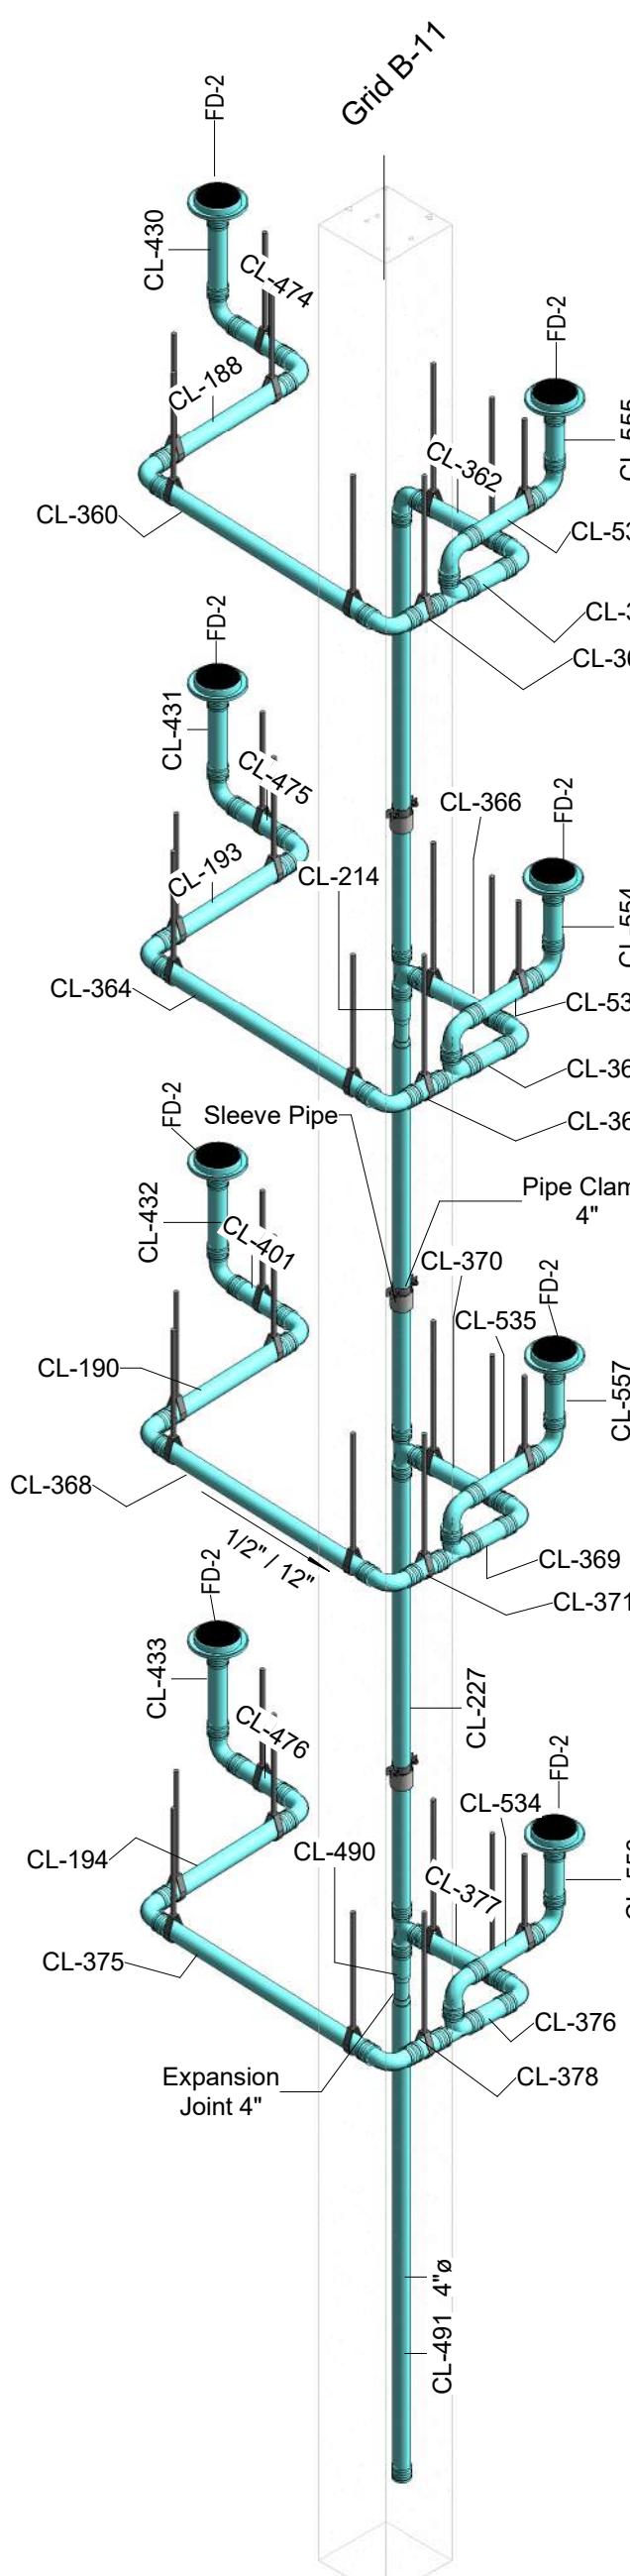


CL-ENLARGE 4

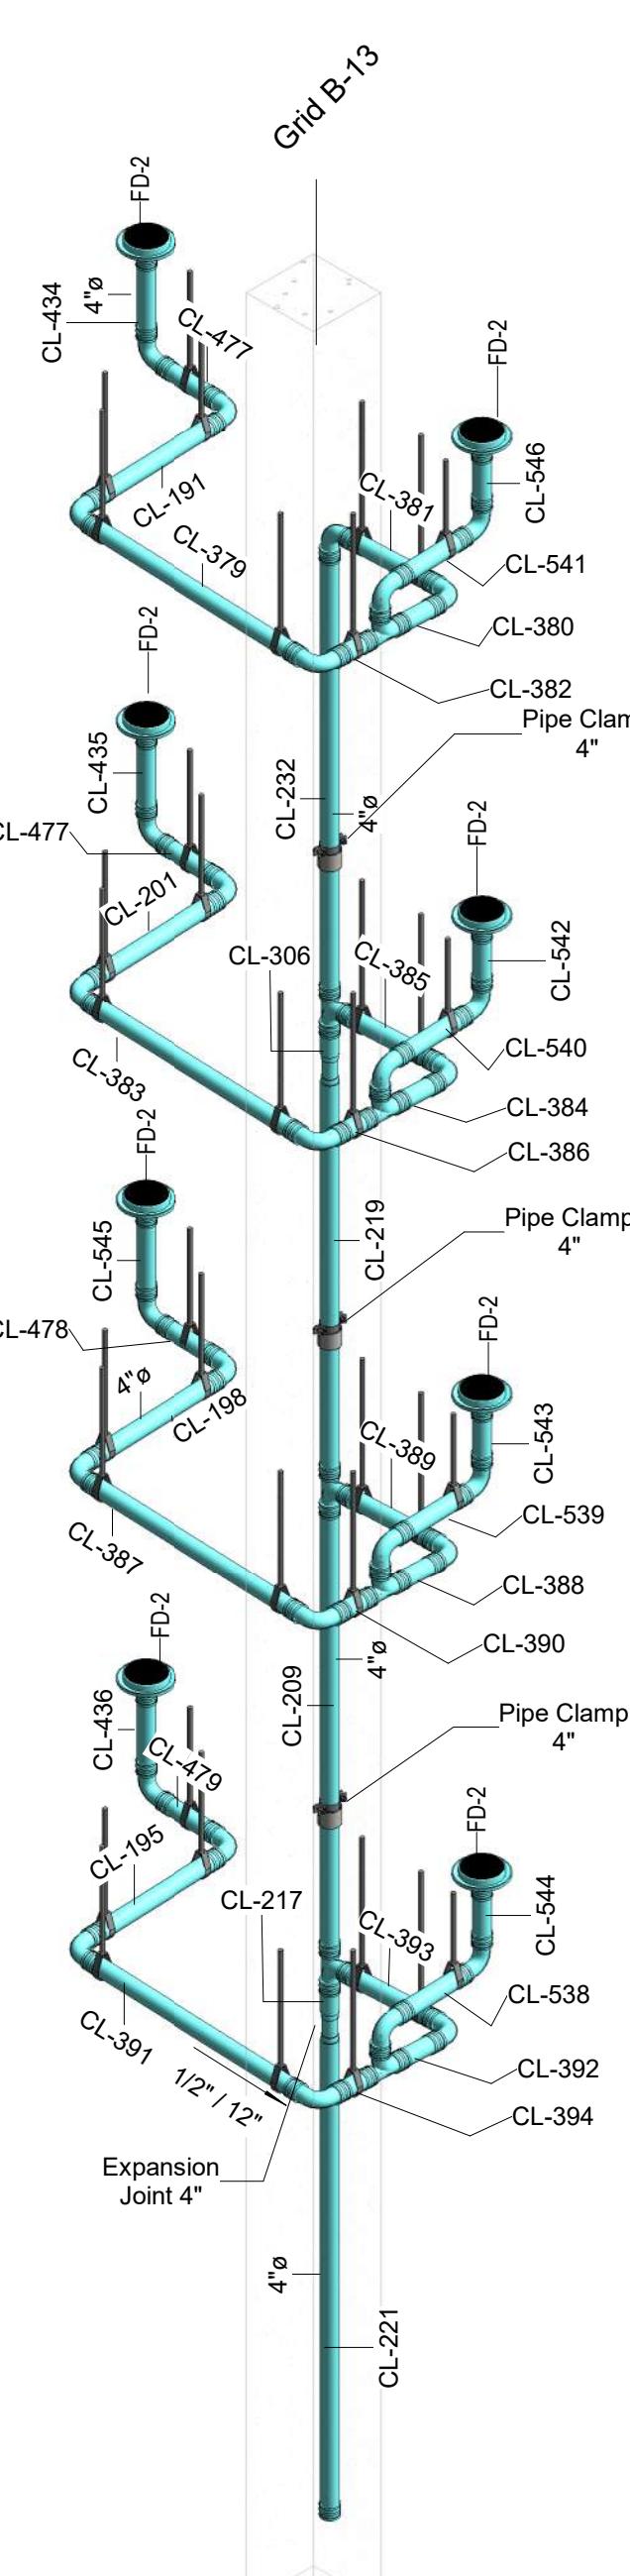

CL-ENLARGE 5

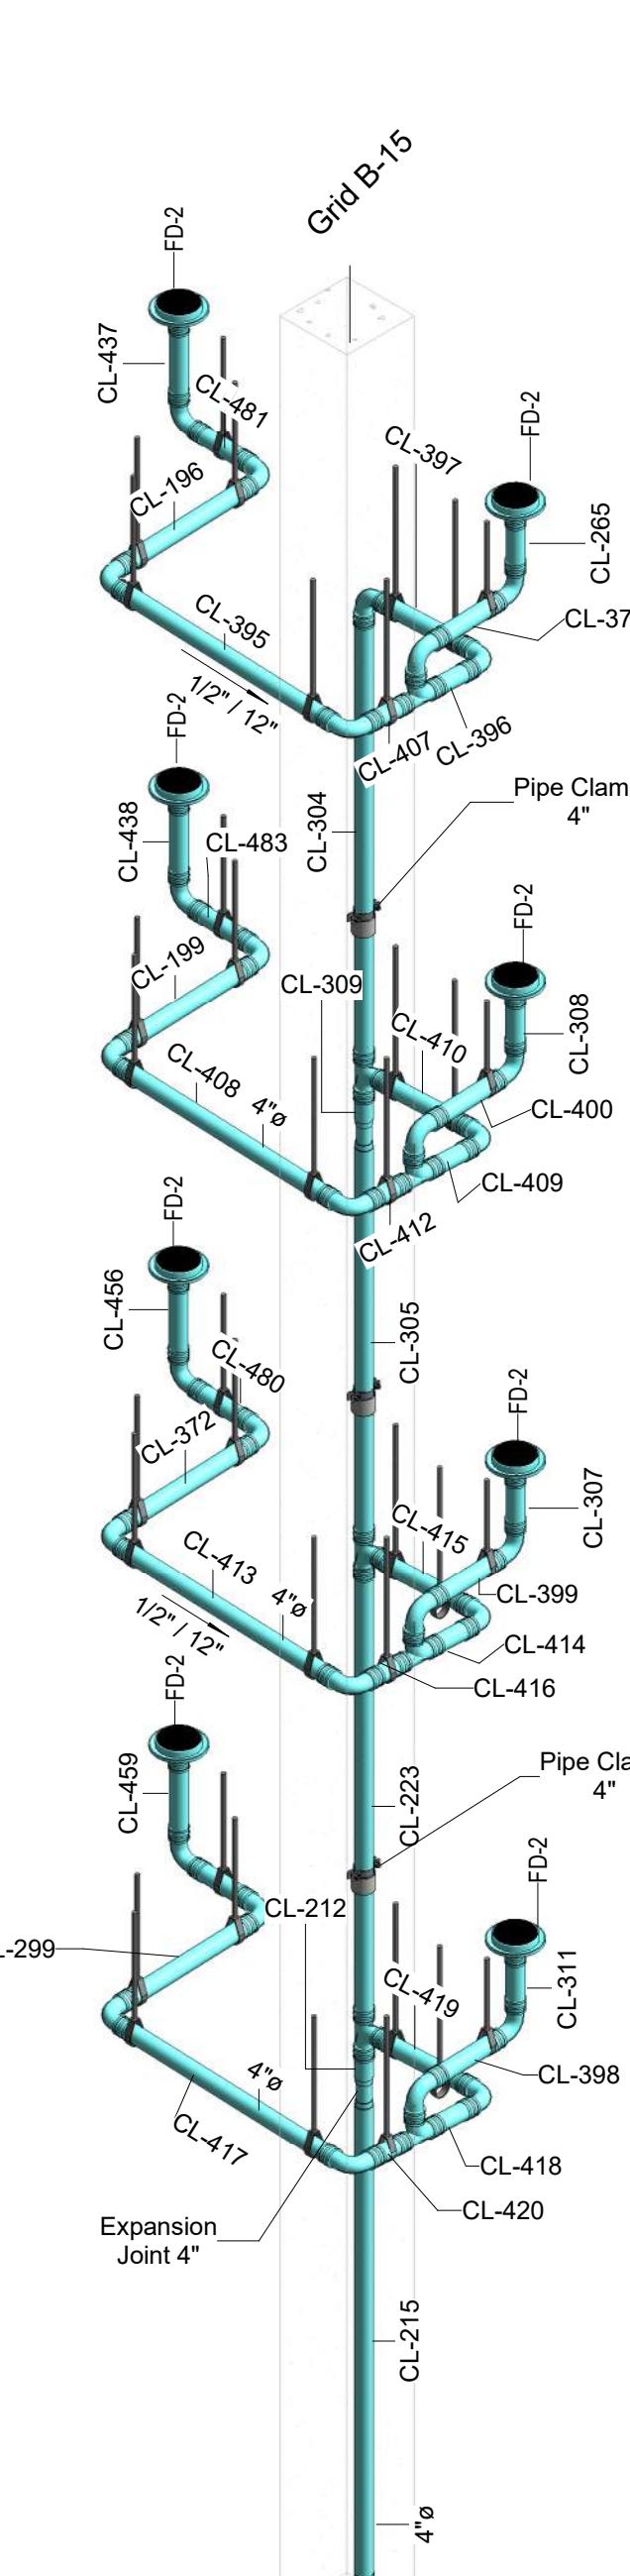

CL-ENLARGE 6

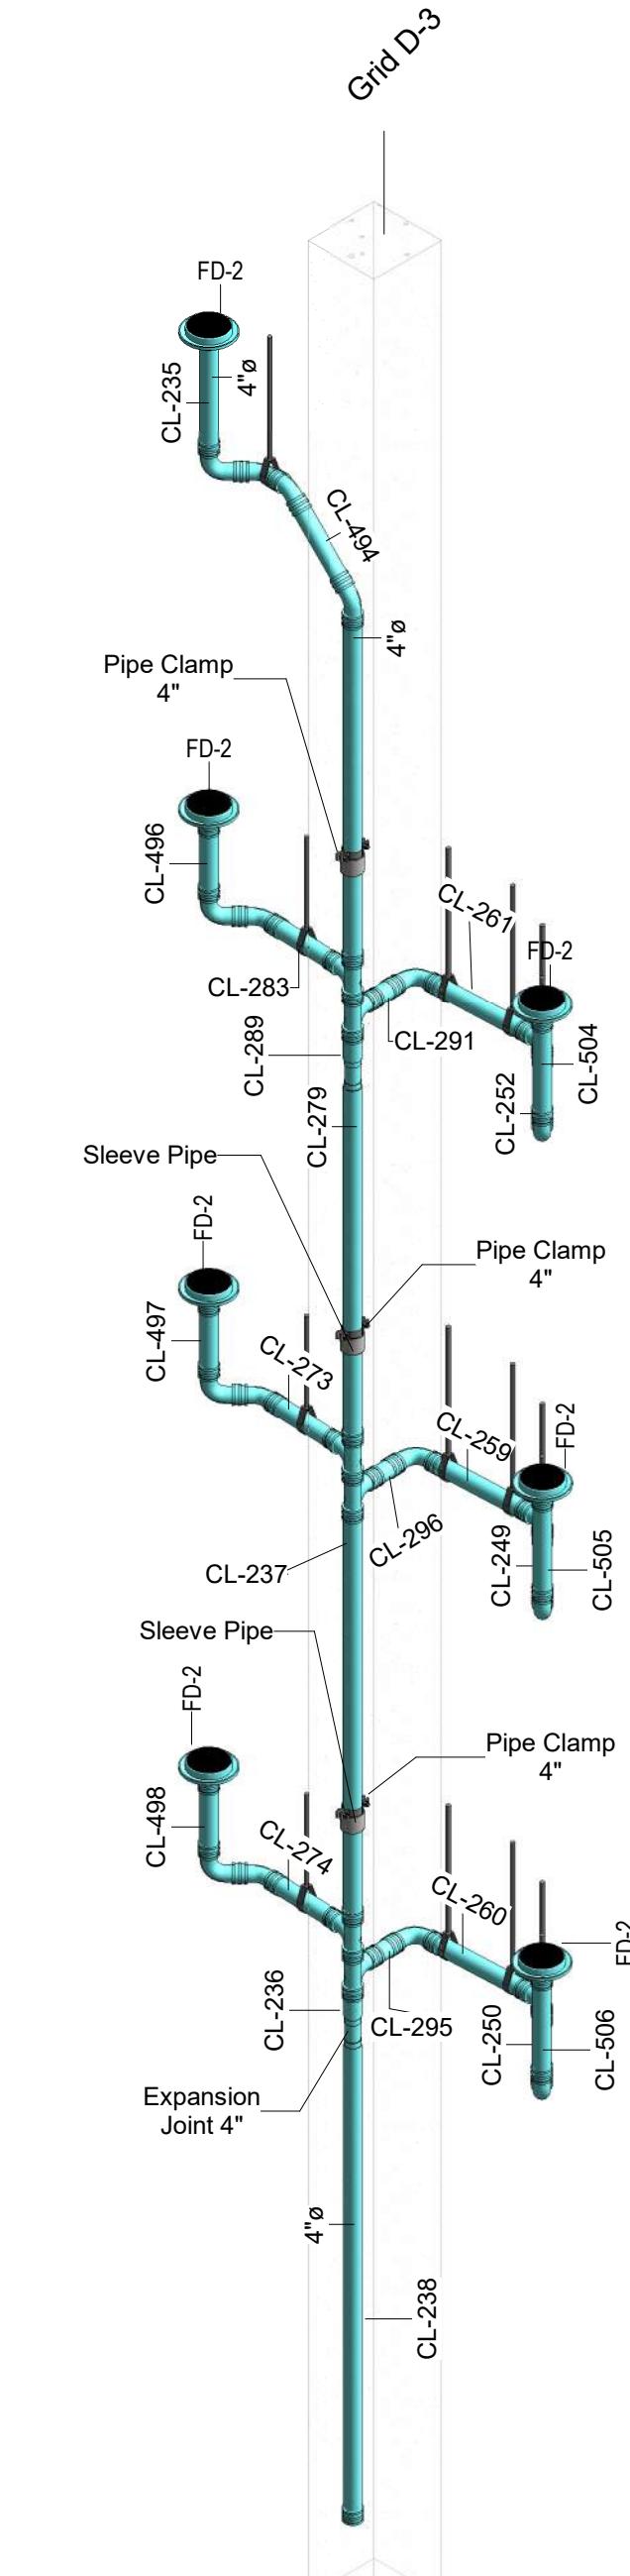

CL-ENLARGE 7

KAUFMAN LYNN CONSTRUCTION - SUBMITTAL
Project No. 1074 Submittal No. #22 0500G-2
Reviewed _____ Make Corrections Noted _____
Submit Specified Item _____

Checking is only for general conformance with the design concept of the project and general compliance with the information given in the Contract Documents. Any action shown is subject to the requirements of the plans and specifications. Subcontractor is responsible for dimensions which shall be confirmed and corrected at the job site, fabrication processes and techniques, see terms of construction, coordination of his/her work with that of all trades, and the satisfactory performance of his/her work.

DATE: 11/20/2019 BY: T. REEDER

SHOP-DRAWING



NOMENCLATURE:

W= COOL WATER
CL= SANITARY DRAIN PIPE
CO= STORM DRAIN PIPE

ST (CO) STORM DRAIN PIPE
ST (CL) SANITARY DRAIN PIPE
W WATER PIPE

REFERENCE DRAWING:

PG-P-001/002 - 101A/101B
102A/102B - 103A/103B -
104A/104B - 105A/105B -
106A/107B - 601/602.

4	11.08.2019	ISSUE FOR REVIEW	INTEG
3	10.28.2019	ISSUE FOR REVIEW	INTEG
2	09.24.2019	ISSUE FOR REVIEW	INTEG
1	06.10.2019	ISSUE FOR REVIEW	INTEG
0	08.18.2019	FREQUENT	INTEG
REV.	DATE	DESCRIPTION	APPROVED

DEVELOPMENT REVIEW
INTEG INTEG

PROJECT:
GOLDEN GLADES - PARKING GARAGE

PROPERTY OF:

LOCATED:
STATE OF FLORIDA / DEPARTMENT OF TRANSPORTATION
MIAMI-DADE
ROAD NO. SR 7 / FINANCIAL PROJECT ID 251684-6-52-01


CONTENT:
SANITARY DRAIN PIPE - CL ENLARGE 3D VIEW

DATE: 08/16/19 SCALE: REVIEW: 4 PROJECT:
CODE: GG-P-017




Reviewed for general conformance to the contract documents. This review does not relieve the vendor or the responsibility of making the work conform to the plans and the FDOT Design Standards.


Submittal #: 39
CDC: I-PLUMBING-GGMTF-021919
Job #: 424
Reviewed by: EDUARDO PEREIRA
Date: 11/08/2019
Vendor: REVISION
Product: SHOP DRAWINGS.

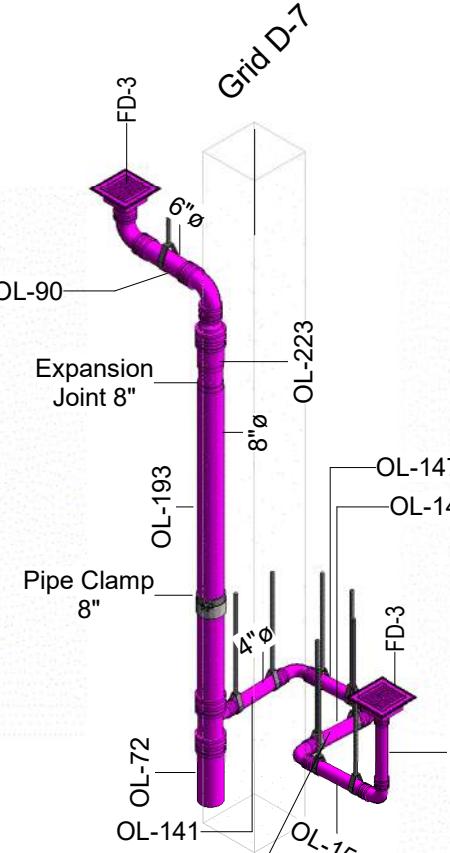


CO-ENLARGE 9

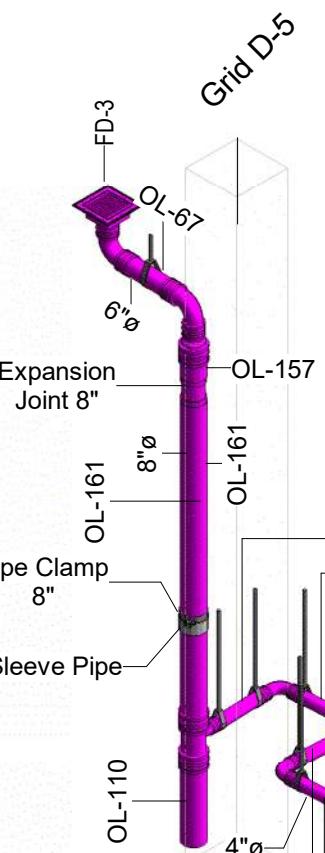


CO-ENLARGE 8

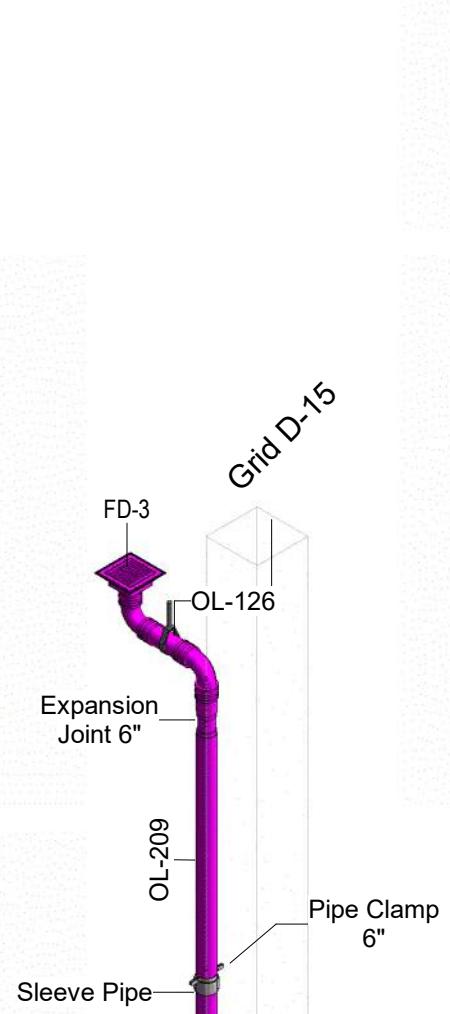


CO-ENLARGE 10

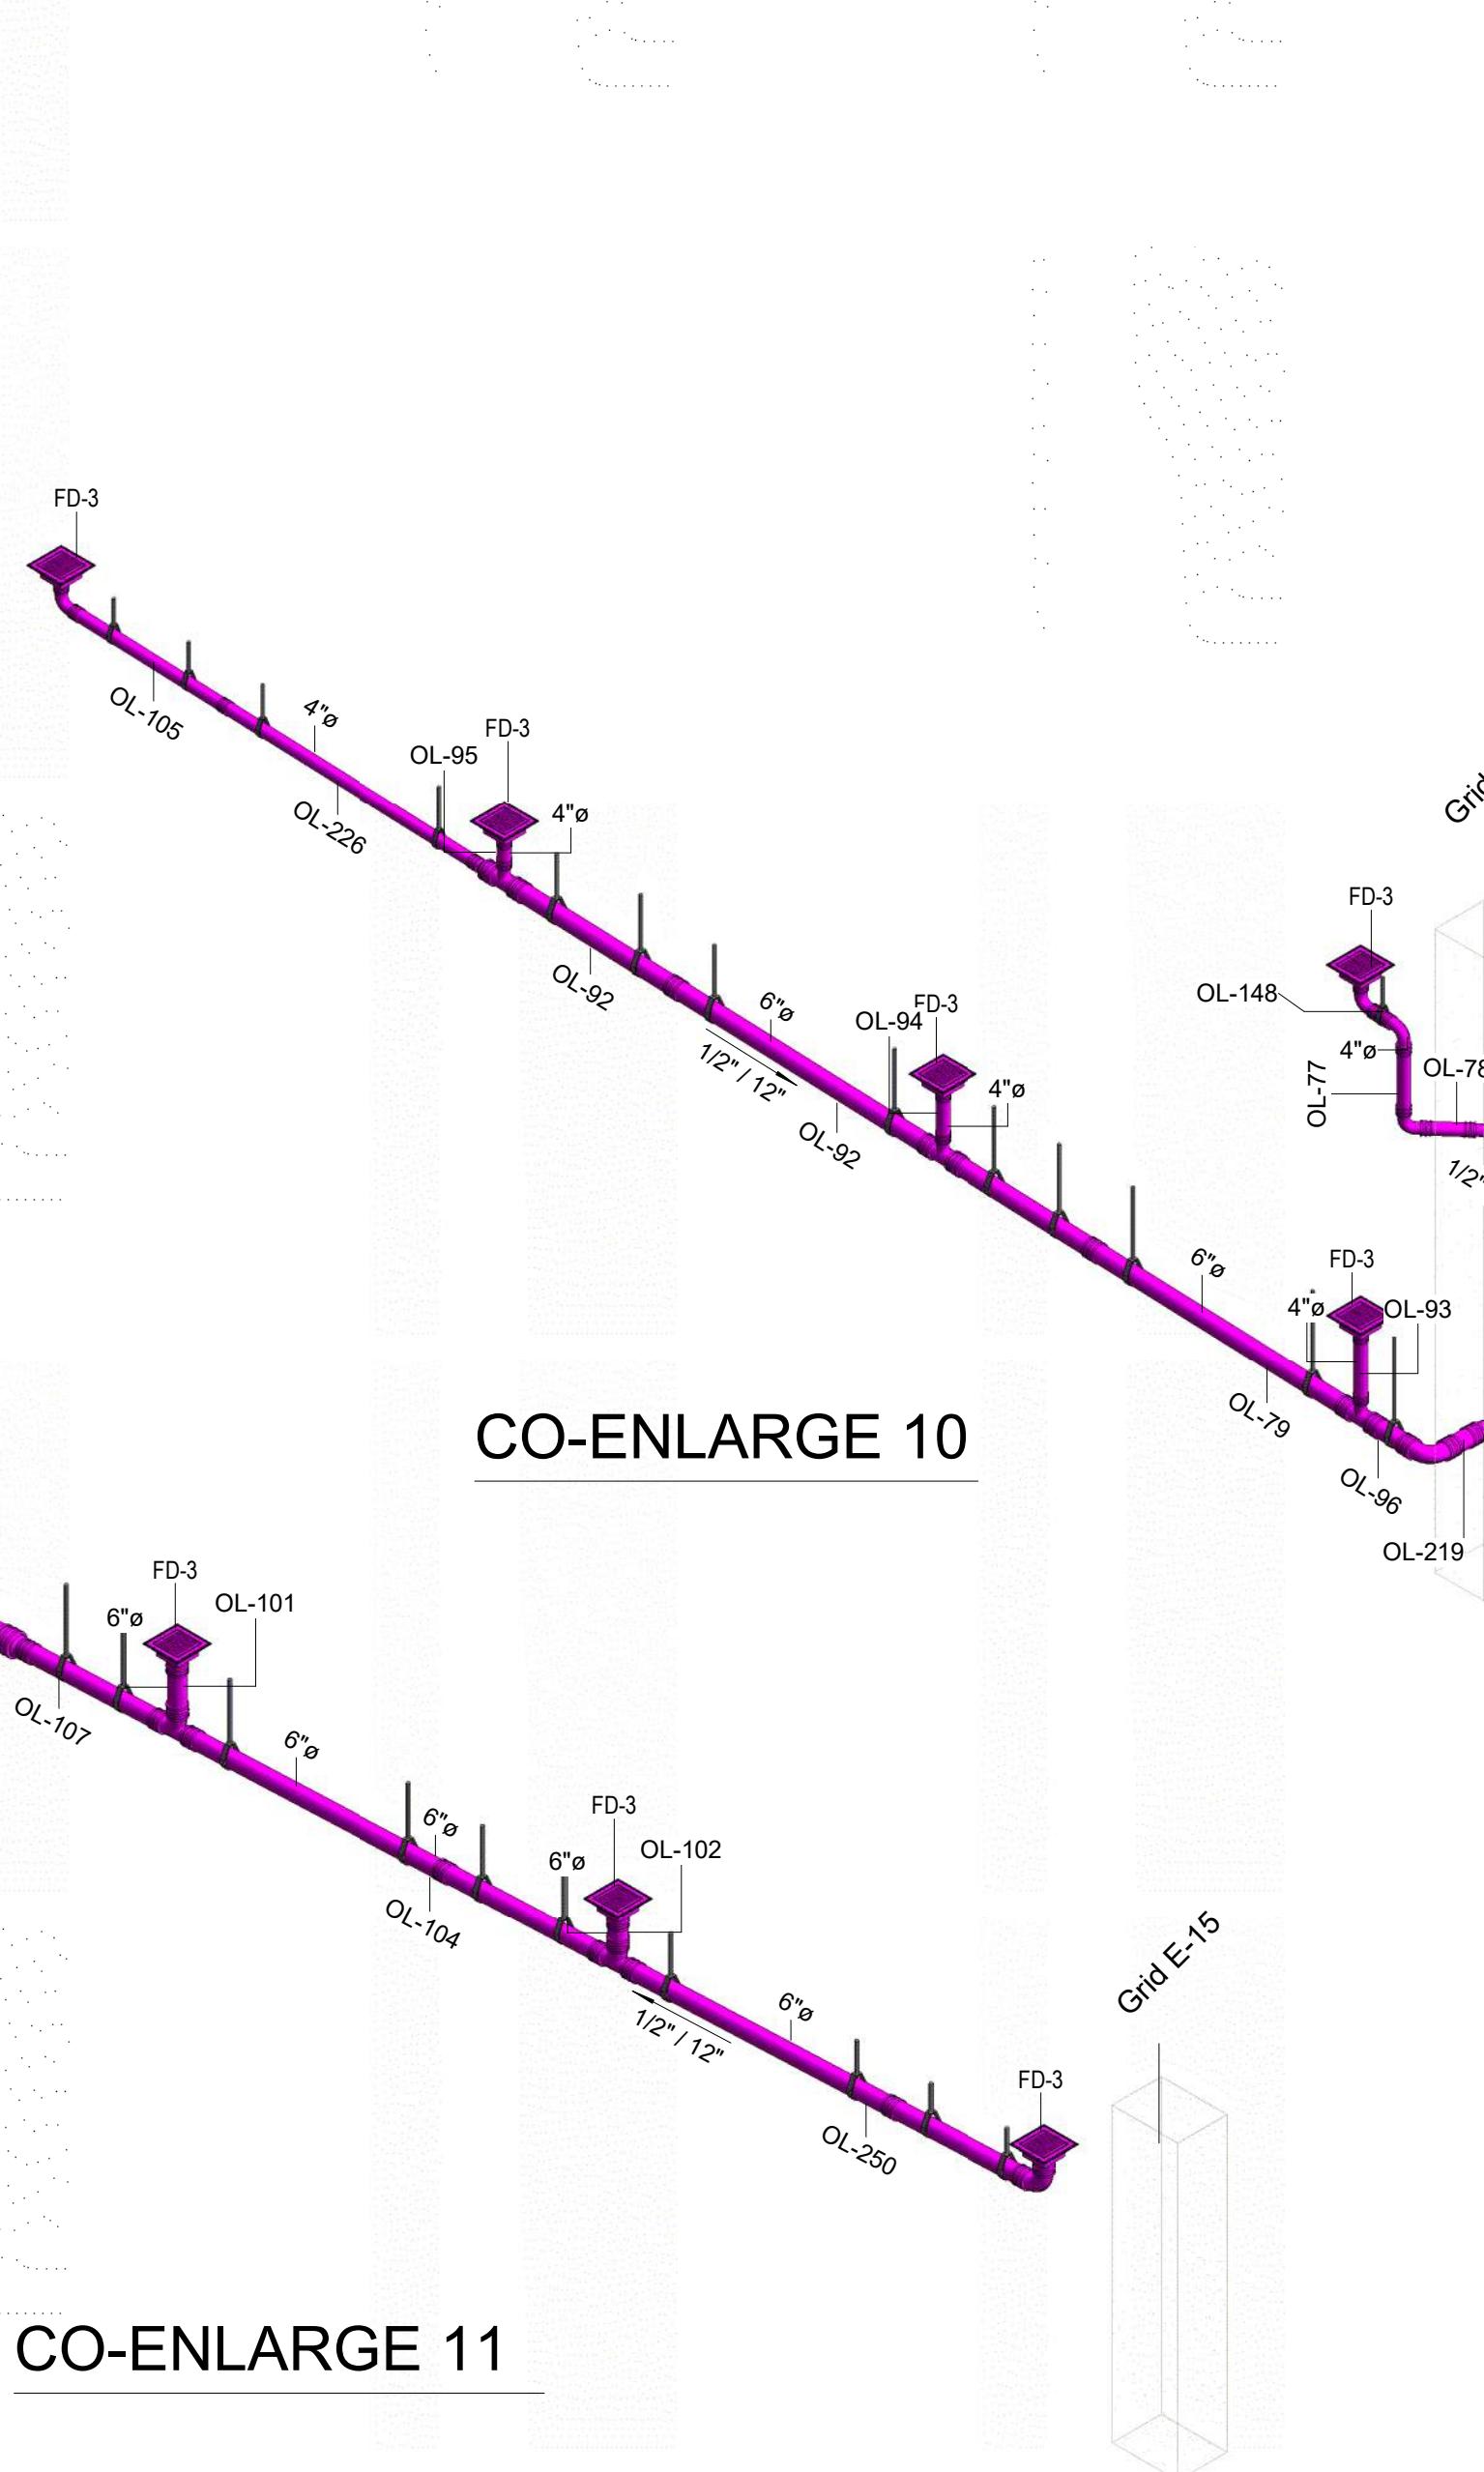


CO-ENLARGE 11

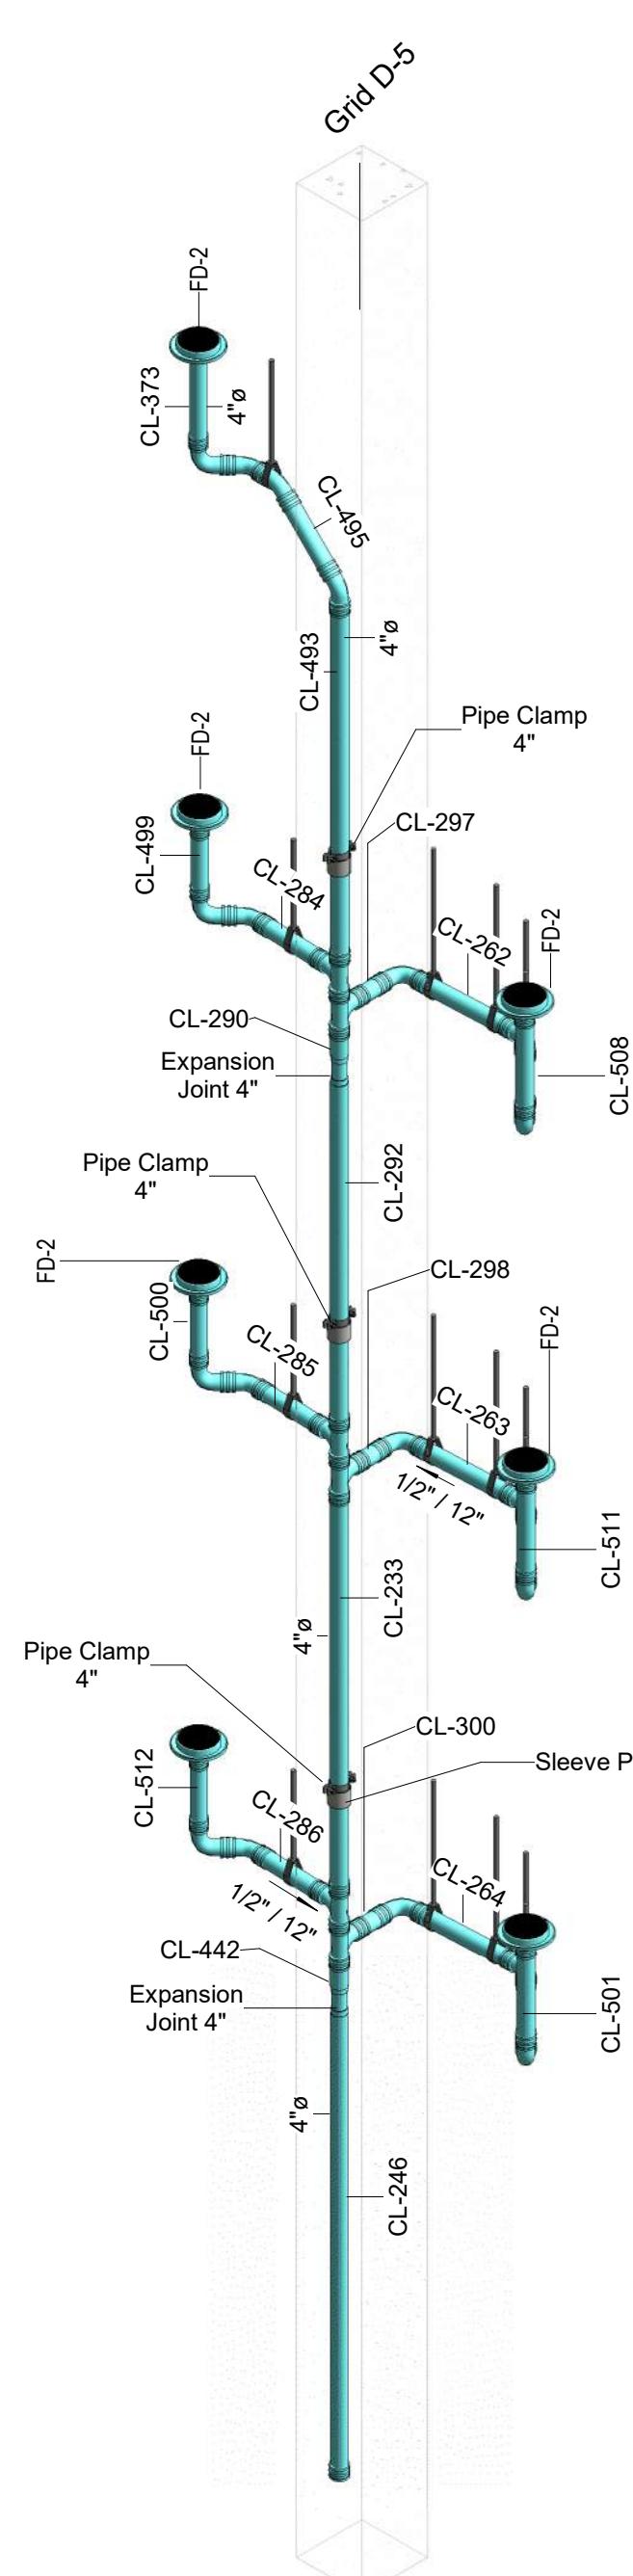


CL-ENLARGE 8

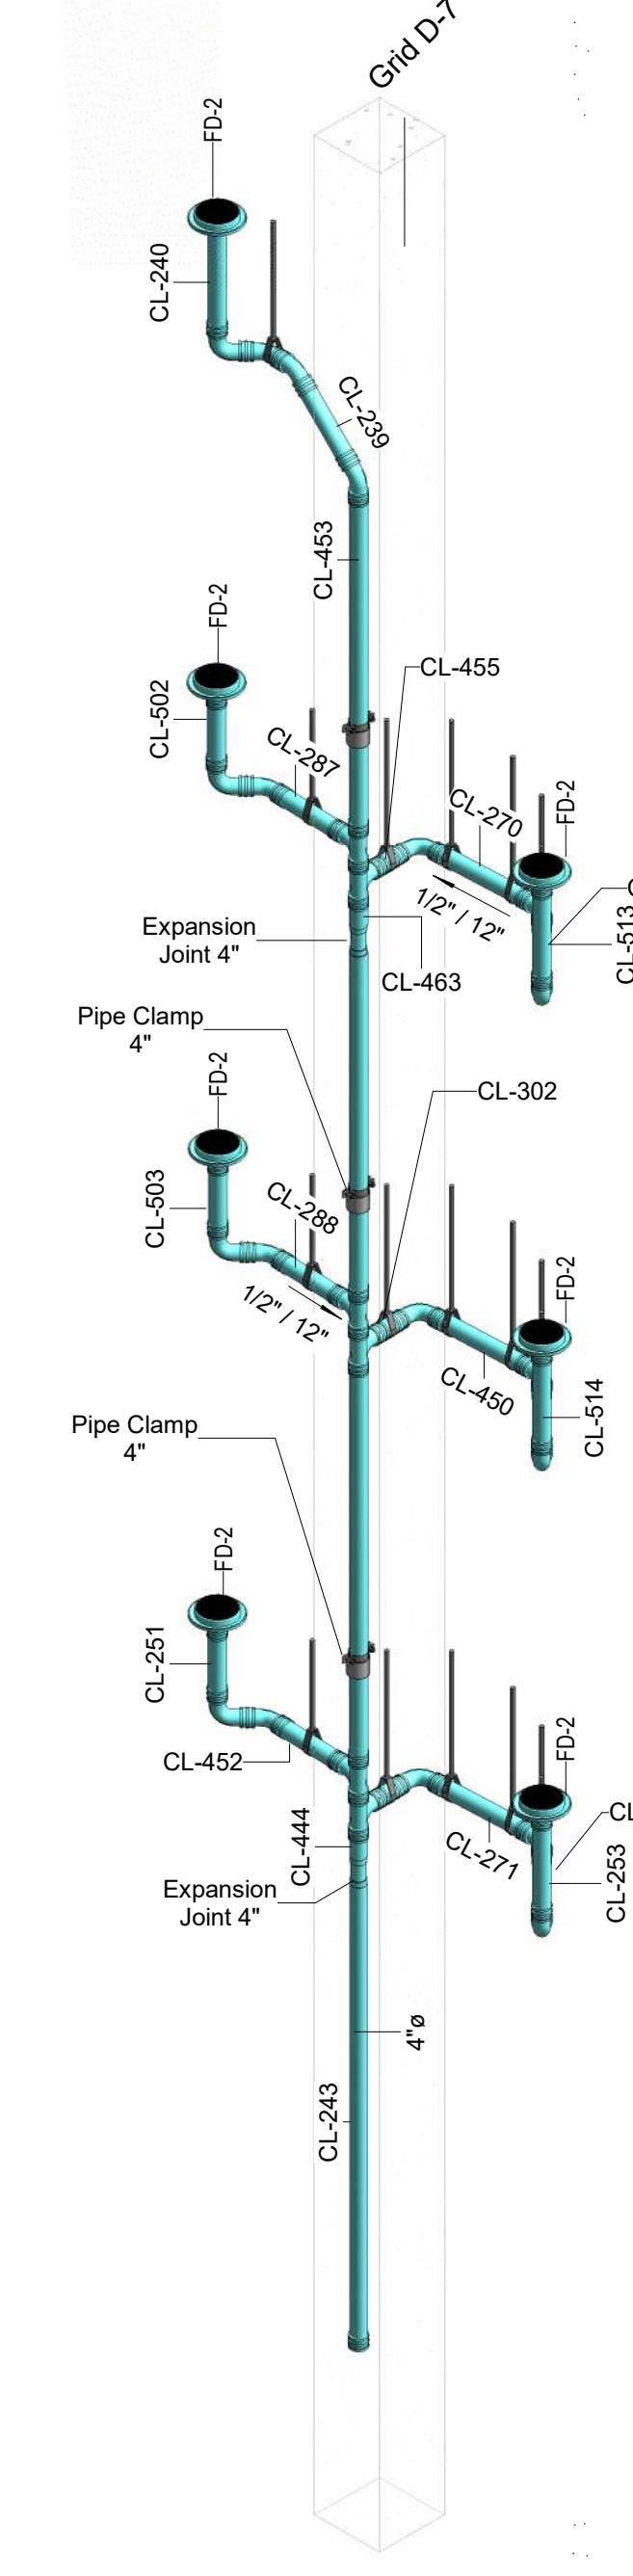

CL-ENLARGE 9

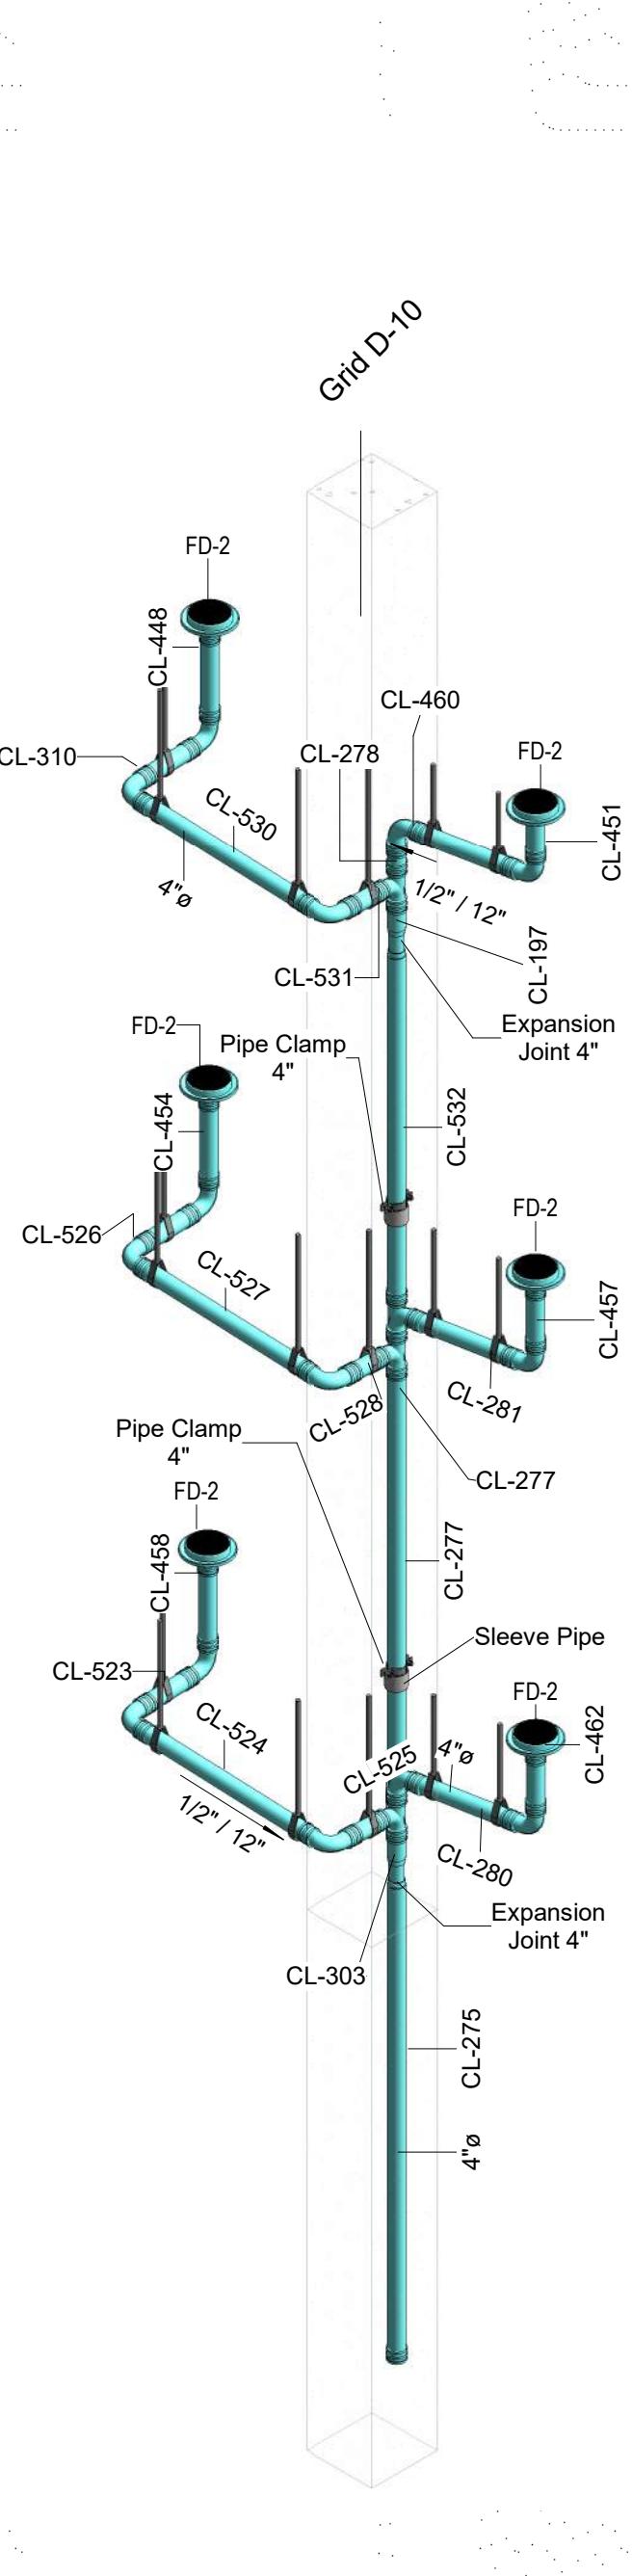

CL-ENLARGE 10

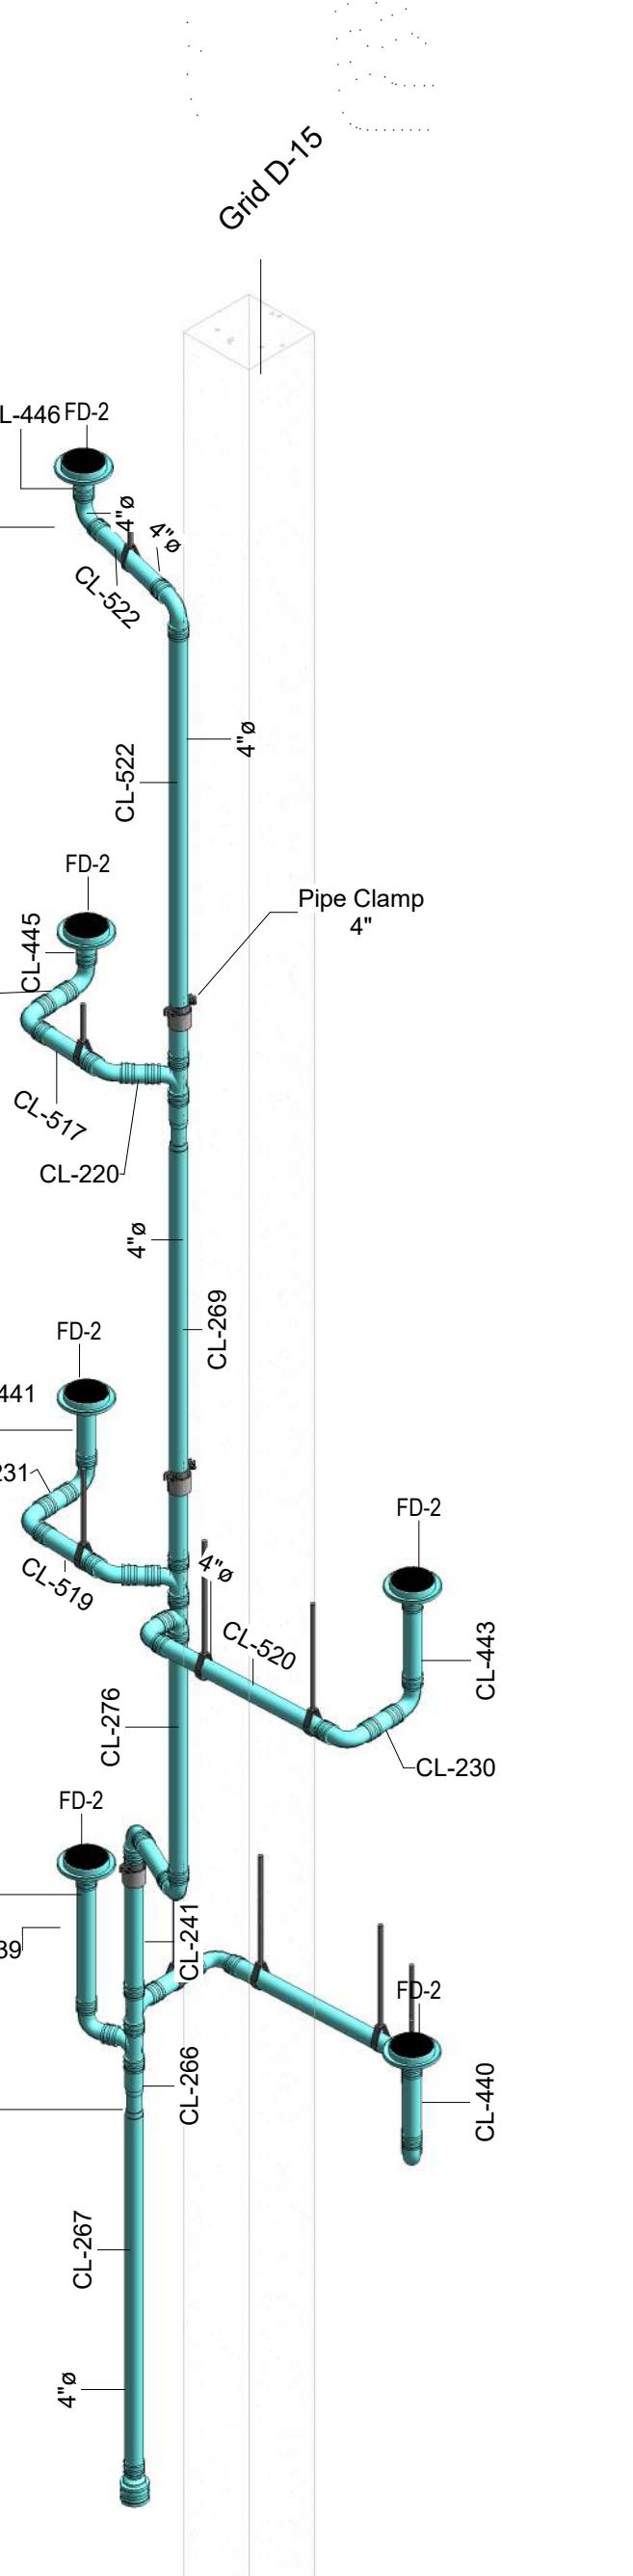

CL-ENLARGE 11



Reviewed for general conformance to the contract documents. This review does relieve the vendor of the responsibility of making the work conform to the plans and the FDOT Design Standards.

Submittal #: 39
CDC: I-PLUMBING-GGMFT-021919
Job #: 424
Reviewed by: EDUARDO PEREIRA
Date: 11/08/2019
Vendor: REVISION
Product: SHOP DRAWINGS

SHOP-DRAWING



NOMENCLATURE:

W= COOL WATER
CL= SANITARY DRAIN PIPE
CO= STORM DRAIN PIPE

ST (CO) STORM DRAIN PIPE
ST (CL) SANITARY DRAIN PIPE
W WATER PIPE

REFERENCE DRAWING:

PG-P-001/002 - 101A/101B
102A/102B - 103A/103B -
104A/104B - 105A/105B -
106A/107B - 601/602.

4	11.08.2019	ISSUE FOR REVIEW	INTEG
3	10.28.2019	ISSUE FOR REVIEW	INTEG
2	09.24.2019	ISSUE FOR REVIEW	INTEG
1	06.10.2019	ISSUE FOR REVIEW	INTEG
0	08.10.2019	FREE FOR REVIEW	INTEG
REV.	DATE	DESCRIPTION	APPROVED

DEVELOPMENT	REVIEW
INTEG	INTEG

PROJECT:
GOLDEN GLADES - PARKING GARAGE

PROPERTY OR:

LOCATED:
STATE OF FLORIDA / DEPARTMENT OF TRANSPORTATION
MIAMI-DADE
ROAD NO. SR 7 / FINANCIAL PROJECT ID 251684-6-52-01

CONTENT:

SANITARY DRAIN & STORM PIPE - CL & CO ENLARGE 3D VIEW

DATE: 08/16/19 SCALE: REVIEW: 4 PROJECT:

CODE: GG-P-018

KAUFMAN LYNN CONSTRUCTION - SUBMITTAL
Project No. 1074 Submittal No. #22 0500G-2
Reviewed Make Corrections Noted

Submit Specified Item
Checking is only for general conformance with the design content of the project and general compliance with the information given in the Contract Documents. Any action shown is subject to the requirements of the plans and specifications. Subcontractor is responsible for dimensions which shall be confirmed and correlated at the job site, fabrication processes and techniques sequences of construction, coordination of his/her work with that of all trades, and the satisfactory performance of his/her work.
DATE: 11/20/2019 BY: T. REEDER

